

KANSAS


Russell

FORM 51 5M BR1X

Section 20 Township 14 Range 13W

Well No. #2 Geo. Rein Jr.

Company Eldorado Ref.

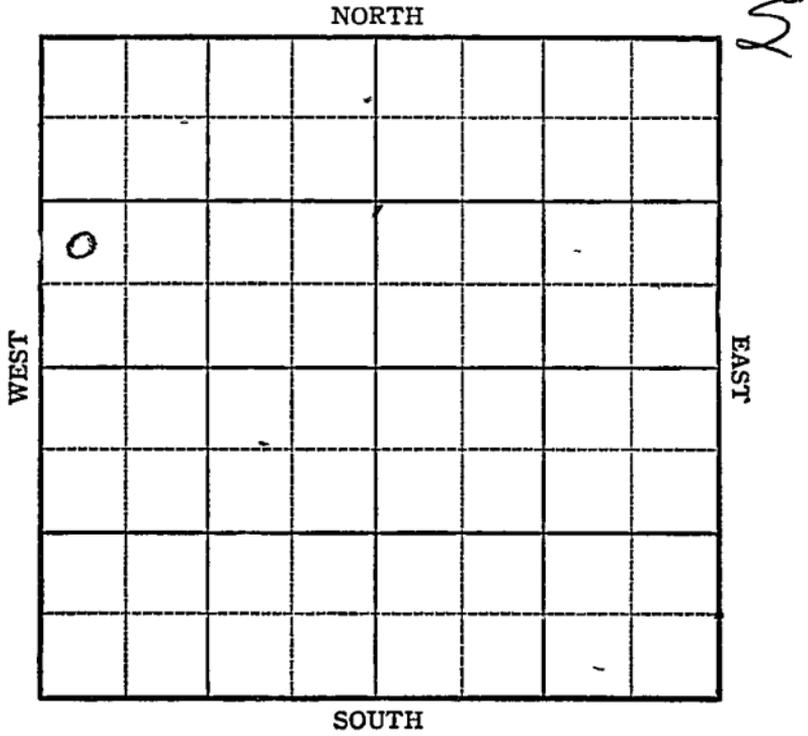

Sec. 20 Twp. 14 R. 13W

Well No. #2 Geo. Rein Jr. Farm

Eldorado Ref. Company


Hall-Gurney

\_\_\_\_\_ Ft. from N. Line

990 Ft. from S. Line

\_\_\_\_\_ Ft. from E. Line

330 Ft. from W. Line

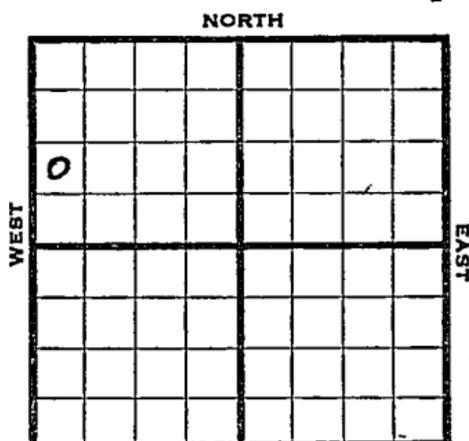

NW SW NW E. No. 1799

1945

R E P O R T

2/14	Location	
2/21	"	
2/28	Rig	
3/7	20" @ 40	
	Drlg 305	
3/14	12" @ 506	
	Drlg 515	
3/23	Anhy 767	
	10" @ 772'	
	Drlg. 1630'	
3/29	Drlg. 1940	
4/5	Dodge	2904
	Lans	2950
	TD 2958' Run 7"	
4/12	7" @ 2956	
	TD 3210'	
	Run 5"	
4/20	Arb 3230	
	TD 3238'	
	5" @ 3219' RUST	
4/27	" " " "	
5/3	30 shots 2315-2345	
	500 acid.	
5/10	Arb 3233 corrected	
5/17	" " "	
5/24	" " "	
5/31	" " "	

OVER

1945

6/13

Arb

3233

5" @ 3219'

1000 acid

Pump 122 oil & 20% Water Pot.

39 0 Gr.

TD 3238'

**COMPLETED**

Pool Name Hall-GurneyMap No. K-72 Sec. 20 Twp. 14 R. 13WWell No. 2 Geo Rein Jr.Eldorado Ref. Company

## FIRST REPORT

Contractor

NW SW NW

## SECTION PLAT

o			

           Ft. from N. Line990 Ft. from S. Line           Ft. from E. Line330 Ft. from W. Line

Russell County

Location XRig up           

Drilling and Remarks:

## RECORD

Cased            in.,            ft.Sand           Gas           Oil           Total Depth           

## PRODUCTION

1st 24 hrs. Nat.           1st 24 hrs. after shot           Gas            Cu. Ft.Dry Hole           Abandoned           

Date

FEB 14 1945 19S. J. LEWIS Scout

