


Russell

Section 16 Township 14 Range 13W

Well No. #5 P. Dumler

Company Lewis Mai

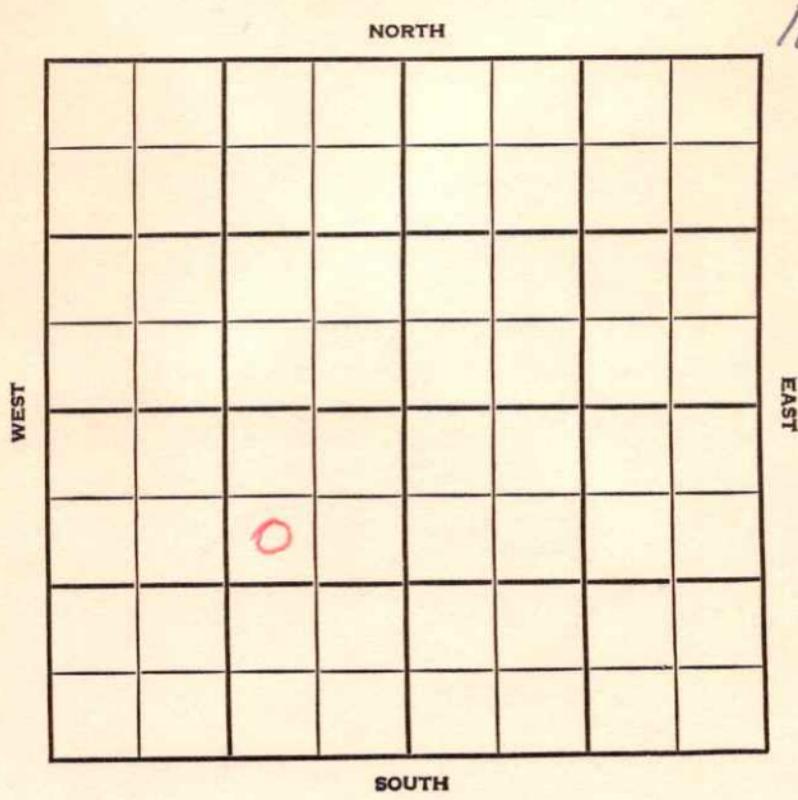

Russell

KANSAS

SEC.	TWP.	R.
16	14	13W

WELL NO. **5 P. Dumler** FARM

COMPANY **Lewis Mai**

CONTRACTOR **Co. Tools**

**Hall-Gurney Pool**


990' \_\_\_\_\_ Ft. from N. Line

\_\_\_\_\_ Ft. from S. Line

990' \_\_\_\_\_ Ft. from E. Line

\_\_\_\_\_ Ft. from W. Line

SW NE SW

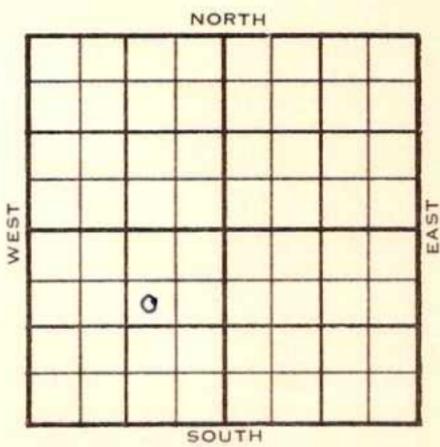

	ELEVATION	REPORT
1955	1860'	
5/25	RUCT	
6/22	Comm 5-27-55 Anh 802, Tr 2391 TD 2414 13" @ 340      10" @ 513 8" @ 805 7" @ 2410 CO to 2414      B/10 goph 10 gw 6 hr 1000A      B/15 goph 10 gw 8 hr Comp 25 bopd 10 bw	
		<b>COMPLETED</b>

County Russell State Kansas

Sec. 16 (Blk. Twp.) 14 (Sur. Rge.) 13W Map No.

Operator Lewis Mai

Well No. 5 Farm P. Dunler

Elev. \_\_\_\_\_ Location SW NE SW


990 Ft. From N Line SW  
 990 Ft. From E Line Quarter

1st. Report MAY 25 1955

Completion \_\_\_\_\_


Remarks \_\_\_\_\_

Co. tools

Spudding Date \_\_\_\_\_

Drlg. Data Hall-Gurney Pool

RUCT

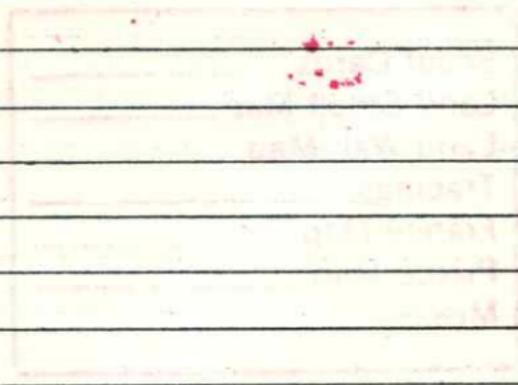

County Russell Elev. 1860  
 Sec. 16 Twp. 14 Rge. 13W  
 Company Lewis Mai  
 Farm Name P. Dumler No. 5

TOPS	DEPTH	LOG	DATUM	Loc. in Sec.
Anh.	<u>802</u>			SW NE SW
Tp.				
H.				
Tr.	<u>2391</u>		<u>531</u>	
Dg.				
Bl.				
L.				Geol. _____
K.C.				Contr _____
B.K.C.				
Ce.				Co. tools _____
C.				
M.				Pool _____
M.				
K.				Hall-Gurney _____
Mz.				
Me.				
V.				
S.				
S.				
A				COMPLETE
R.				
Pe.				
G.				
TD.	<u>2414</u>			

Date Comm. 5-27-55 JUN 22 1955

13" @ 340 10" @ 513 8" @ 805

7" @ 2410 CO to 2414 B/ 10 goph

10 gw 6 hr. 1000 A B/ 15 goph

10 gw 8 hr. Comp. 25 bopd 10 bw