


Section 17 Township 14 S Range 13W

Well No. 6 Ehrlich "B"

Company Murfin Drl g

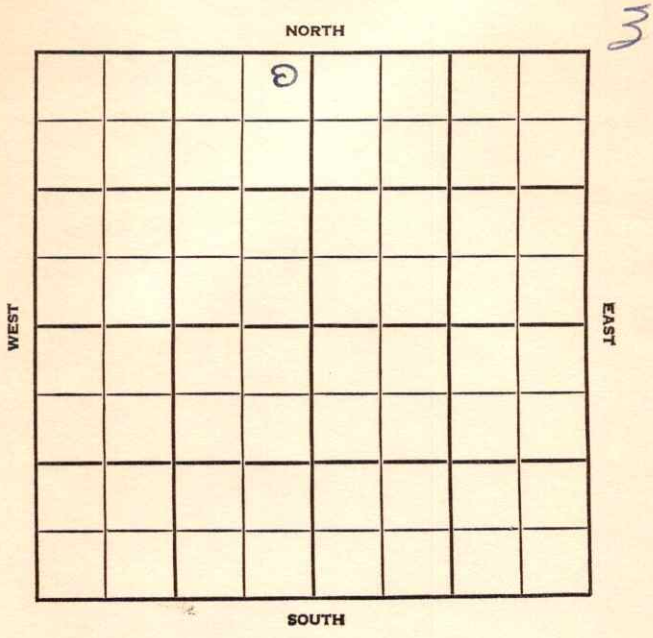

SEC.	TWP.	R.
17	14	13 W
WELL NO. # 6 Ehrlich "B"		FARM
COMPANY		

Murfin Drlg.

CONTRACTOR

Co. tools
Hall-Gurney Pool


330 Ft. from N. Line

Ft. from S. Line

330 Ft. from E. Line

Ft. from W. Line

NE NE NW

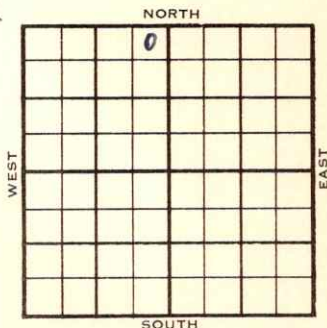

1955

ELEVATION

1856'

REPORT

4/20

Spud 4-15-55
8" @ 150 Anhy 818'

Drlg. 1862'

6/1

Comm 4-15-55
~~Tark~~ Anh 818, Tarkio 2397
8" @ 150/100 5 1/2" @ 2397 CO to
2419 DD 2402 1 boph 16 hr frac
Comp 4 bopd 25 bw

COMPLETED

County Russell Elev. 1856
 Sec. 17 Twp. 14 Rge. 13W
 Company Murfin Drlg.
 Farm Name Ehrlich "B" No. 6

TOPS	DEPTH	LOG	DATUM	Loc. in Sec.
Anh.	<u>818</u>			NE NE NW
Tp.				
H.				
Tr.				
Dg.				
BL.				Geol. _____ Contr. _____ Pool _____ Hall-Gurney
Tarkio	<u>2397</u>		<u>541</u>	
K.C.				
B.K.C.				
Ce.				
C.				
M.				
M.				
K.				
Mz.				
Me.				
V.				
S.				
S.				
A				
R.				
Pe.				
G.				
T.D.				

X

COMPLETE

Date Comm. 4-15-55 JUN 1 1955

8" @ 150/100 5 1/2" @ 2397 CO to 2419

DD 2402 1 bopd 16 hr. frac

Comp. 4 bopd 25 bw

Section 17 Township 14 Range 13W

Well No. 6 Ehrlich "B"

Company Murfin Drlg.

