

# KANSAS


FORM 51 5M 4-41 PETROL

Russell

Section 20 Township 14 Range 13-W

Well No. #2 Opdycke

Company Stearns et al

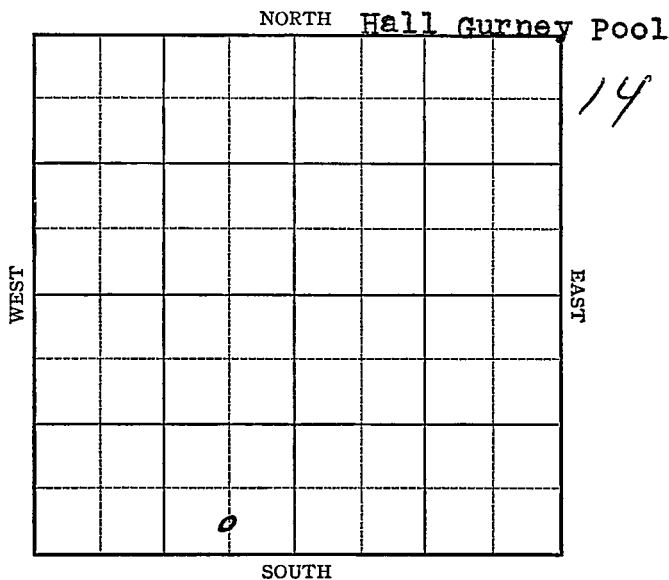


Sec. 20 Twp. 14 R. 13-WWell No. #2 Opdycke FarmStearns et al Company

(Hall Gurney)

\_\_\_\_\_ Ft. from N. Line

330 Ft. from S. Line660 Ft. from E. Line

\_\_\_\_\_ Ft. from W. Line

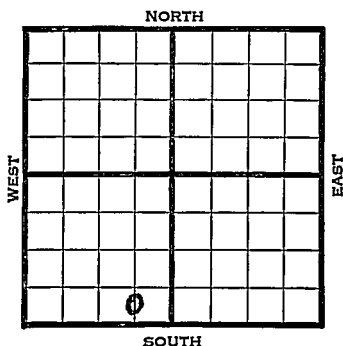

Elev. 1772

1941	REPORT
4/30	Cable location.
5/8	"
5/15	20" - 53' Drlg. 170'
5/22	15" - 370' 13" - 415'
	Anhy 723' 10" - 724'
	Drlg. 875'
5/28	Drlg. 1740'
6/5	8" - 2411' Drlg. 2490'
6/12	Lans. 2910-12' T.D.
	7" - 2910' WOC.
6/19	TD 2943' SD.
6/25	Lans. 2910'
	7" - 2910'
	T.D. 3047'
	P.B. to 3015'
	500 acid.
	Potential 1940 bbls., pump.
	38.3 Gravity
	<b>COMPLETED</b>

Map No. 72 Sec. 20 Twp. 14 R. 13W

Well No. 2 Opdycke

Stearns etal Company

Contractor

**FIRST REPORT**

C S L SE SW

         Ft. from N. Line

330 Ft. from S. Line

660 Ft. from E. Line

         Ft. from W. Line

**SECTION PLAT**


**HALL GURNEY POOL**

Location X

Rig' up         

Drilling and Remarks:

Cable

**RECORD**

Cased          in.,          ft.

Sand         

Gas         

Oil         

Total Depth         

**PRODUCTION**

1st 24 hrs. Nat.         

1st 24 hrs. after shot         

Gas          Cu. Ft.

Dry Hole         

Abandoned         

Date

APR 30 1941<sub>19</sub>

S. J. LEWIS Scout

Map No. \_\_\_\_\_ Sec. 20 Twp. 14 R. 13W

Well No. 2 Opdycke

Stearns etal Company

\_\_\_\_\_  
Contractor

**COMPLETED**

C S L S E S W

\_\_\_\_\_ Ft. from N. Line

330 Ft. from S. Line

660 Ft. from E. Line

\_\_\_\_\_ Ft. from W. Line

SECTION PLAT


HALL GURNEY POOL

Location \_\_\_\_\_

Rig up \_\_\_\_\_

Drilling and Remarks:

*Loss 2910*  
*7" C 2910*  
*PA 3615*  
*500 acid*  
*Pump 1940 P & S*  
*353 Gr*

RECORD

Cased \_\_\_\_\_ in., \_\_\_\_\_ ft.

Sand \_\_\_\_\_

Gas \_\_\_\_\_

Oil \_\_\_\_\_

Total Depth 3049

PRODUCTION

1st 24 hrs. Nat. \_\_\_\_\_

1st 24 hrs. after shot \_\_\_\_\_

Gas \_\_\_\_\_ Cu. Ft.

Dry Hole \_\_\_\_\_

Abandoned \_\_\_\_\_

Date

JUN 25 1941 19

S. J. LEWIS Scout