

Section 20 Township 14 Range 13WWell No. 3-Opdycke (Twin)Company Stearns Dlg. et al

NORTH							
SOUTH							

WEST

EAST

0

13

Sec. 20 Twp. 14 R. 13-WWell No. #3 Opdycke (Twin well) FarmStearns Drilling et al Company

(Hall-Gurney)


Ft. from N. Line

330 Ft. from S. Line

Ft. from E. Line

660 Ft. from W. Line

Elev. 1775

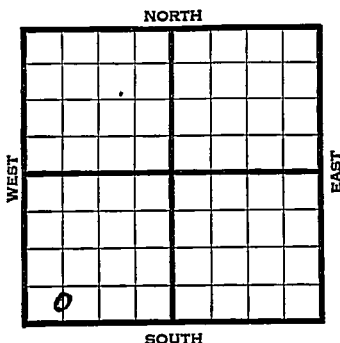

1941	REPORT
9/3	Cable.
9/11	20" - 60' 15" - 253'
	13" - 415' Drlg. 505'
9/18	Anhy. 712' 10" - 712'
	Drlg. 1550'
9/25	Drlg. 2230'
10/2	Drlg. 2865'
10/9	Lans. 2914' 7" - 2910'
	Drlg. 2952'
10/16	7" - 2916' T.D. 3015' S.S.O.
	Shut down.
10/23	" "
10/29	Lans. 2914'
	7" - 2916'
	T.D. 3015'
	3000 acid.
	Potential 361 bbls., pump.
	38.3 Gravity
	COMPLETED

Map No. _____ Sec. 20 Twp. 14 R. 13W

Well No. 3 Opdycke (Twin Well)

Stearns Drilling etal Company

FIRST REPORT

Contractor

C S L SW SW

_____ Ft. from N. Line

330 _____ Ft. from S. Line

_____ Ft. from E. Line

660 _____ Ft. from W. Line

SECTION PLAT

o			

HALL GURNEY POOL

Location _____

Rig up _____

Drilling and Remarks:

Cable

RECORD

Cased _____ in., _____ ft.

Sand _____

Gas _____

Oil _____

Total Depth _____

PRODUCTION

1st 24 hrs. Nat. _____

1st 24 hrs. after shot _____

Gas _____ Cu. Ft.

Dry Hole _____

Abandoned _____

Date

SEP 3 1941 19

S. J. LEWIS Scout

Map No. K-72 Sec. 20 Twp. 14 R. 13WWell No. 3 Opydcke (Twin well)Stearns et al CompanyCOMPLETED Contractor

C SL SW SW

 Ft. from N. Line330 Ft. from S. Line Ft. from E. Line660 Ft. from W. Line

SECTION PLAT

HALL GURNEY POOL

Location Rig up

Drilling and Remarks:

Line 29142" 2916.3000 acidPump 361 Pst.353

RECORD

Cased in., ft.Sand Gas Oil Total Depth 3015

PRODUCTION

1st 24 hrs. Nat. 1st 24 hrs. after shot Gas Cu. Ft.Dry Hole Abandoned

Date

OCT 29 1941S. J. LEWIS

Scout