


Section 16 Township 14 Range 13W

Well No. 9 Dumler

Company Lee Phillips

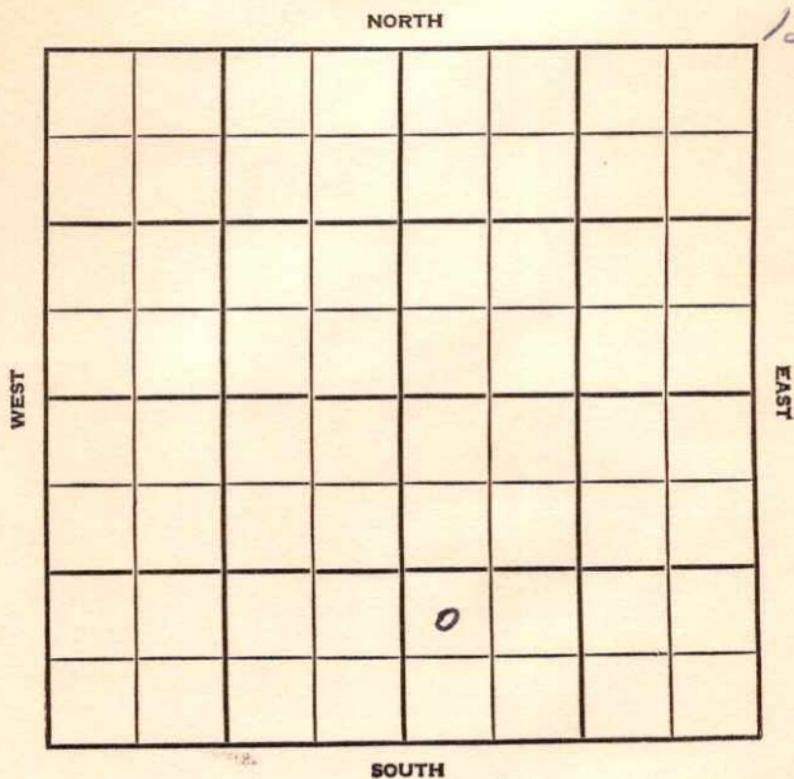

Russell

KANSAS

SEC.	TWP.	R.
16	14	13 W

WELL NO. # 9 Dumler FARM

COMPANY Lee Phillips

CONTRACTOR Mast Drlg.

Hal 1-Gurney Pool


\_\_\_\_\_ Ft. from N. Line

990 \_\_\_\_\_ Ft. from S. Line

\_\_\_\_\_ Ft. from E. Line

330 \_\_\_\_\_ Ft. from W. Line

NW SW SE

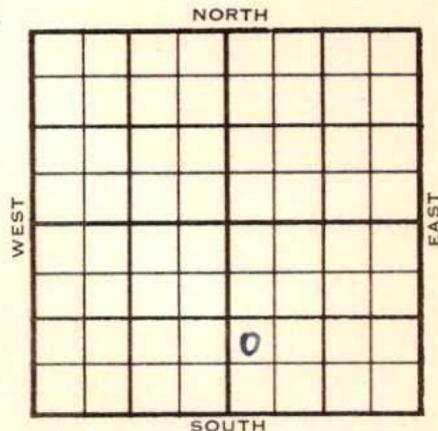

1955	ELEVATION	REPORT
------	-----------	--------

4/20 Spud 4-17-55  
8" @ 227 WOC

6/18 5 1/2" @ 2401/100 CO to 2412, 60/23 86-97  
B/4 goph 12 hr. frac B/1.14 boph P/20  
bopd DD 2412 CO 2397 Comp 9 Bppd

Tops	Depth	Datum
H.	2373	516
Anh.	807	
Tr. Tarkio	2386-90	529
TD.	2408	

COMPLETED

County Russell State Kansas

Sec. 16 (Blk. Twp.) 14 (Sur. Rge.) 13W Map No.

Operator Lee Phillips

Well No. 9 Farm Dumler

Elev. \_\_\_\_\_ Location NW SW SE


990 Ft. From S Line SE

330 Ft. From W Line Quarter

1st. Report APR 20 1955

Completion \_\_\_\_\_

Remarks \_\_\_\_\_

Mast Drlg. - Contr.

Spudding Date 4-17-55

Drlg. Data Hall-Gurney Pool

8" @ 227 WOC

FABEN GILSTRAP

County Russell Elev. 1857  
 Sec. 16 Twp. 14 Rge. 13W  
 Company Lee Phillips  
 Farm Name Dumler No. 9

TOPS	DEPTH	LOG	DATUM
Anh.	<u>807</u>		
Tr.			
H. <u>Gr Haven</u>	<u>2373</u>		<u>516</u>
Tr. <u>Tarkio sd</u>	<u>2386-90</u>		<u>529</u>
Dg.			
B.L.			
L.			
K.C.			
B.K.C.			
Ce.			
C.			
M.			
M.			
K.			
Mz.			
Ma.			
V.			
S.			
S.			
A.			
R.			
Pe.			
G.			
T.D.	<u>2408</u>		

Loc. in Sec. \_\_\_\_\_  
 NW SW SE  
 Geol. \_\_\_\_\_  
 Contr. \_\_\_\_\_  
 Mast Drlg.  
 Pool \_\_\_\_\_  
 Hall-Gurney

COMPLETE

Date Comm. 4-17-55 JUN 8 1955  
8" @ 227/125 5 1/2" @ 2401/100 CO to 2412  
60/ 2386-91 B/ 4 goph 12 hr. frac  
B/ 1.14 boph P/ 20 bopd DD 2412  
CO 2397 Comp. 9 bopd

Co.  
 Lse.  
 No.  
 Sec.  
 T.  
 R.