

KANSAS


FORM 51 5M 11-44 PETROL

Russell County

Section 20 Township 14 Range 13W

Well No. #4 Opdyoke

Company Stearns Drlg. et al

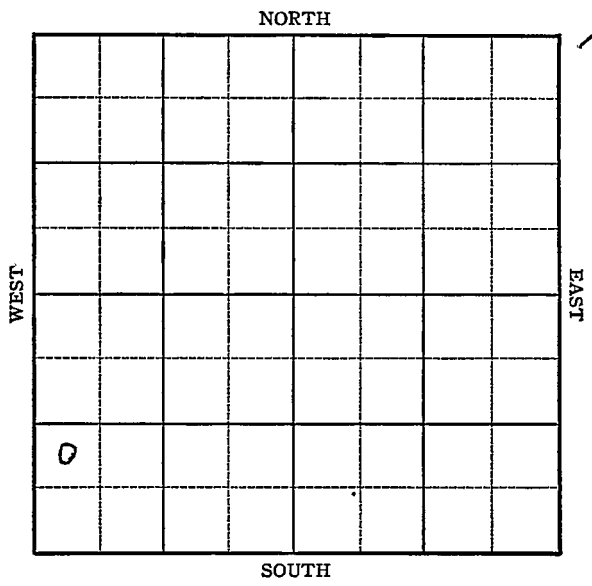

Sec. 20 Twp. 14 R. 13-W

Well No. #4 Opdyoke Farm \_\_\_\_\_

Stearns Drlg et al Company \_\_\_\_\_


Hall-Gurney

\_\_\_\_\_ Ft. from N. Line

990 Ft. from S. Line

\_\_\_\_\_ Ft. from E. Line

330 Ft. from W. Line

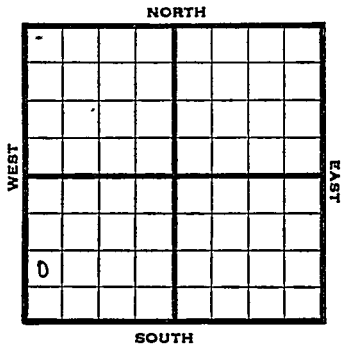

NW SW SW

1946 1777 REPORT

- 6/19 Location
- 6/26 Spud 140'
- 7/3 10" @ 739 SD
- 7/9 Anhy 733  
Drlg 1500'
- 7/16 Tarkio 2290  
S Gas, Drlg 2300'
- 7/23 SD 2480'  
8" @ 2487' oil & W 2542-50  
1850' fluid, testing
- 7/30 8" @ 25 52  
Drlg 2600'
- 8/6 8" @ 2650 -  
TD 2668' SO
- 8/13 Swb 22 oil PH 48 hrs
- 8/20 " " "
- 8/27 " " "
- 9/5 " " "
- 9/10 " " "
- 9/18 " " "
- 9/25 Topeka 2650'  
8" @ 2650'  
TD 2668'  
Pump 91 POT  
Grav 39

COMPLETED

**KANSAS** Kansas Pool Name Hall-Gurney  
 Map No. 72 Sec. 20 Twp. 14 R. 13W

Well No. 4 Opdyoke

Stearns Drlg etal Company

**FIRST REPORT**

Contractor

NW SW SW

           Ft. from N. Line

990 Ft. from S. Line

           Ft. from E. Line

330 Ft. from W. Line

**SECTION PLAT**

o			

**Russell County**

Location X

Rig up           

Drilling and Remarks:

**RECORD**

Cased            in.,            ft.

Sand           

Gas           

Oil           

Total Depth           

**PRODUCTION**

1st 24 hrs. Nat.           

1st 24 hrs. after shot           

Gas            Cu. Ft.

Dry Hole           

Abandoned           

Date

JUN 19 1946

19

S. J. LEWIS

Scout

