


Section 16 Township 14 Range 13-W

Well No. #1 Lewis

Company Skelly

*2*

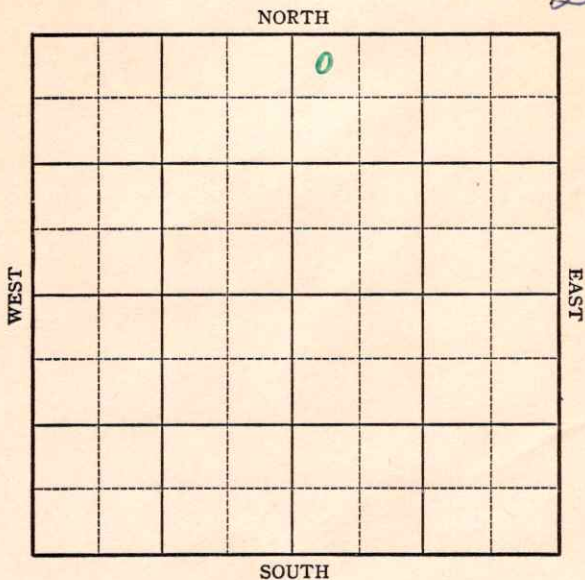



Map No. 72 Sec. 16 Twp. 14 R. 13W

Well No. 1 Lewis

Skelly Company

**FIRST REPORT** Contractor

NW NE


SECTION PLAT

330 Ft. from N. Line

\_\_\_\_\_ Ft. from S. Line

\_\_\_\_\_ Ft. from E. Line

330 Ft. from W. Line

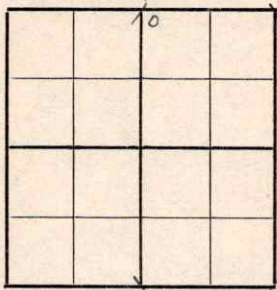

WILD CAT

Location XX

Rig up \_\_\_\_\_

Drilling and Remarks:

RECORD

Cased \_\_\_\_\_ in., \_\_\_\_\_ ft.

Sand \_\_\_\_\_

Gas \_\_\_\_\_

Oil \_\_\_\_\_

Total Depth \_\_\_\_\_

PRODUCTION

1st 24 hrs. Nat. \_\_\_\_\_

1st 24 hrs. after shot \_\_\_\_\_

Gas: \_\_\_\_\_ Cu. Ft.

Dry Hole \_\_\_\_\_

Abandoned \_\_\_\_\_

Date

MAY 6 1942 19

S. J. LEWIS Scout

KANSAS

Russell

Map No. 72 Sec. 16 Twp. 14 R. 13W

Well No. 1 Lewis

Skelly Company

**ABANDONED** Contractor

SECTION PLAT

NW NE

330 Ft. from N. Line

\_\_\_\_\_ Ft. from S. Line

\_\_\_\_\_ Ft. from E. Line

330 Ft. from W. Line

		0	

WILDCAT

RECORD

Location \_\_\_\_\_

Cased \_\_\_\_\_ in., \_\_\_\_\_ ft.

Rig up \_\_\_\_\_

Sand \_\_\_\_\_

Drilling and Remarks:

Gas \_\_\_\_\_

Oil \_\_\_\_\_

Total Depth 3372

*BKC 3312*

*CEX 3347*

*Wichita*

PRODUCTION

1st 24 hrs. Nat. \_\_\_\_\_

1st 24 hrs. after shot \_\_\_\_\_

Gas \_\_\_\_\_ Cu. Ft.

Dry Hole \_\_\_\_\_

Abandoned \_\_\_\_\_

Date

MAY 27 1942 19

S. J. LEWIS Scout