

Section 17 Township 14 Range 13W

Well No. #4 A. Rein

Company Advance Drlg.

NORTH

2

				0			

WEST

EAST

SOUTH

SEC.	TWP.	R.
17	14	13 W ✓

WELL NO. # 4 A. Rein FARM

COMPANY Advance Drlg.

CONTRACTOR Advance Drlg.


Hall-Gurney Pool

330 Ft. from N. Line

Ft. from S. Line

Ft. from E. Line

330 Ft. from W. Line

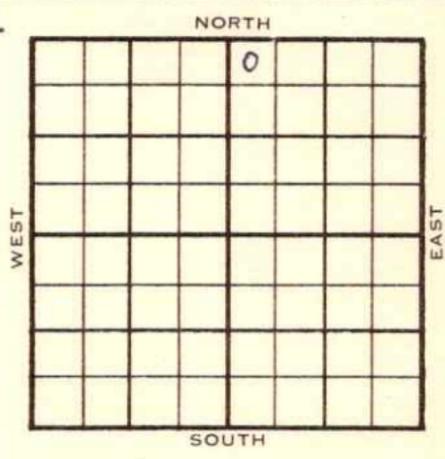

NW NW NE

1954	ELEVATION	REPORT
	1867'	

1/27	MIR
2/3	10" @ 319 8" @ 512 Drlg. 660'
2/10	7" @ 824' Drlg. 1345'
2/17	Drlg. 2250'
2/24	Tarkio 2405 5" @ 2405 12 GOPH TD 2431 wtr.
3/3	NR
3/17	Spud 1-28-54 Oil Well TD 2431' 10" @ 319' 8" @ 512' 7" @ 824' Tarkio 2405' 5" @ 2405' 12 goph TD 2431 wtr CO to 2415 12/2409-12 Sd-frac, S/2 boph omp. 25 bopd

COMPLETED

