

Sec. 20 Twp. 14 R. 13W

Well No. #6 Opdycke Farm
Stearns Oil Company

Hall-Gurney Pool


_____ Ft. from N. Line

990' Ft. from S. Line

330' Ft. from E. Line

_____ Ft. from W. Line

NE SE SW

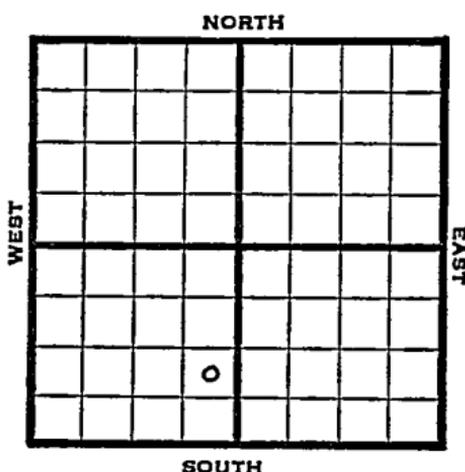

1948

Eli 1781' REPORT

7/8	10" @ 451' Anhy. 735' Drlg. 1750'
7/14	Dodge 2884' Drlg 2964'
7/21	"
7/28	Lansing 3130' Cong 3219' Arb. 3244'-84' TD 3284' 7"@ 3264' SED
8/4	"
8/11	"
8/18	"
8/25	"
9/1	Drlg. 3281'
9/8	3300 fsg.
9/15	Drilling by tools
9/21	"
9/29	"
10/6	"
10/13	"
10/19	"
10/26	"
11/3	"

OVER

Map No. _____ Sec. 20 Twp. 14 R. 13W

Well No. 6 Opdycke

Stearns Oil Company

FIRST REPORT Contractor

NE SE SW

SECTION PLAT



FORM 51 10M 8-47


KANSAS

Russell

Section 20 Township 14 Range 13-W

Well No. #6 Opdycke

Company Stearns Oil

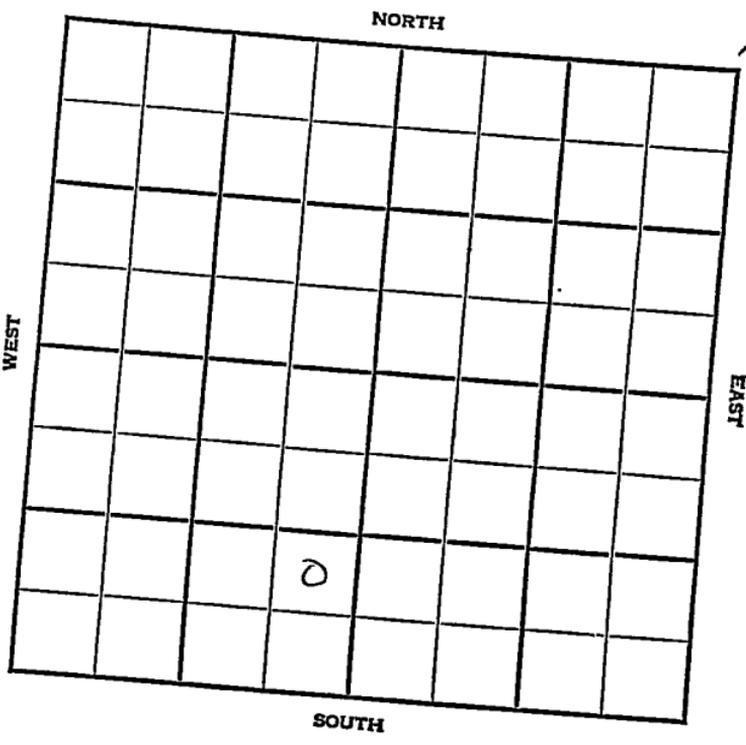

1948

11/10

TD 3304
Arb. 3244
7@-3264
SWD
Aband.

ABANDONED

Map No. _____ Sec. 20 Twp. 14 R. 13WWell No. 6 Opdycke_____ Stearns Oil _____ Company

FIRST REPORT

_____ Contractor

NE SE SW

SECTION PLAT

		o	

_____ Ft. from N. Line

990 Ft. from S. Line330 Ft. from E. Line

_____ Ft. from W. Line

Russell County

Location _____

Rig up _____

Drilling and Remarks:

10" @ 451Anhy 735drlg. 1750

RECORD

Cased _____ in., _____ ft.

Sand _____

Gas _____

Oil _____

Total Depth _____

PRODUCTION

1st 24 hrs. Nat. _____

1st 24 hrs. after shot _____

Gas _____ Cu. Ft.

Dry Hole _____

Abandoned _____

Date

JUL 8 1948 19 _____ S. J. LEWIS Scout

