


Section 17 Township 14 Range 13 W

Well No. # 5 Ehrlich "B"


Company Murfin Drlg.

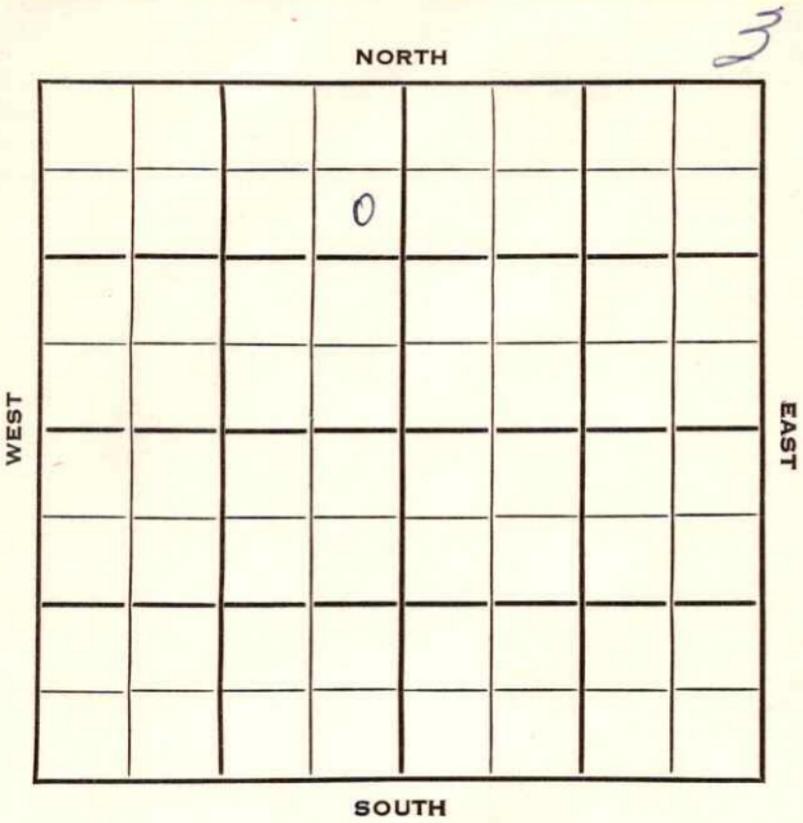

SEC.	TWP.	R.
17	14	13 W ✓
WELL NO. # 5 Ehrlich "B"		FARM
COMPANY		
Murfin Drlg.		
CONTRACTOR		

Hall-Gurney Pool

990 Ft. from N. Line
 _____ Ft. from S. Line
 330 Ft. from E. Line
 _____ Ft. from W. Line

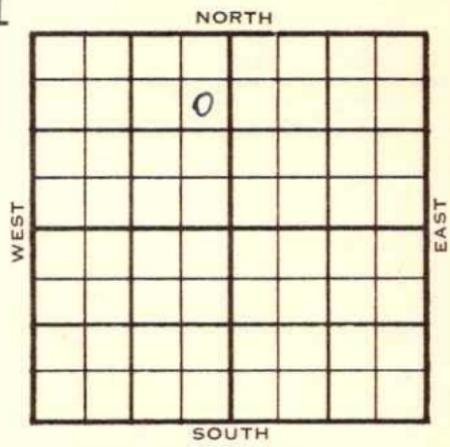

SE NE NW

	ELEVATION	REPORT
1954	1867'	
2/3		Cellar & Pits
2/10		"
2/17		Gd Haven 2395' 1st Tarkio 2408' RTD 2450'
2/24		5" @ 2449
3/3		15/2409-11 6/2415-16 st-frac FU 1200' fluid 40% oil
3/10		NR
3/31		D & A TD 2450' Grandhaven 2395', 1st Tarkio 2408', TD 2450' 5" @ 2449' 15/ 2409-11 6/ 2415-16 st-frac. FU 1200' fluid 40% oil P/ 20 bwpd. D & A

ABANDONED

