

Barton


KANSAS

Form 51-5M 5-37 Petrol

Section 13 Township 16 Range 14-W

Well No. 1 Eckart

Company Shell

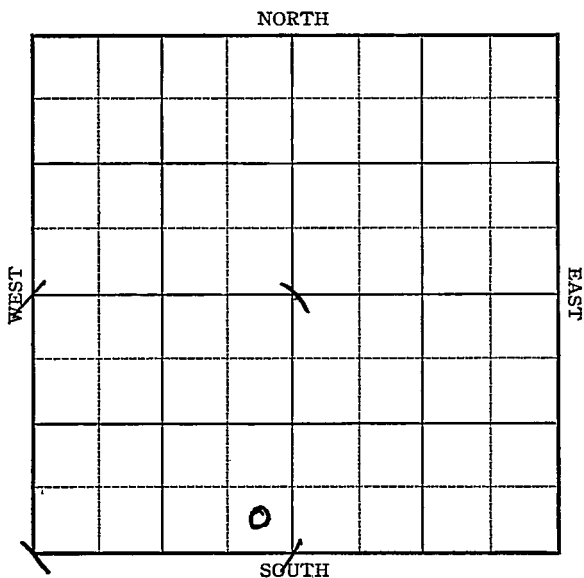

Map No. 73 Sec. 13 Twp. 16 R. 14WWell No. 1 EckartShell

Company


Contractor

FIRST REPORT

SE SW

 Ft. from N. Line330 Ft. from S. Line330 Ft. from E. Line Ft. from W. Line

SECTION PLAT

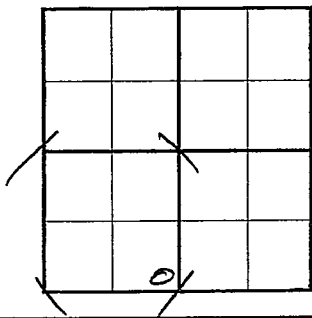Location Rig up

Drilling and Remarks:

RR

RECORD

Cased in., ft.Sand Gas Oil Total Depth

PRODUCTION

1st 24 hrs. Nat. 1st 24 hrs. after shot Gas Cu. Ft.Dry Hole Abandoned

Date

NOV 23 1937

19

H. D. Hatfield

Scout

Barton

KANSAS

Map No. 73 Sec. 13 Twp. 16 R. 14WWell No. 1 EckartShell

Company

Contractor

ABANDONED
SE SW

SECTION PLAT

 Ft. from N. Line330 Ft. from S. Line330 Ft. from E. Line Ft. from W. LineLocation Rig up

Drilling and Remarks:

400' water @ 3417

RECORD

Cased 4 in. 3385 ft.Sand 4-6 3382Gas Oil Total Depth 3423

PRODUCTION

1st 24 hrs. Nat. 1st 24 hrs. after shot Gas Cu. Ft.Dry Hole Abandoned

Date

JAN 5 - 1938 19 H. D. Hatfield Scout