

Section 17 Township 14 Range 13W

Well No. #3 Ehrlich "C"

Company Murfin Drlg.

NORTH

5

	0						

WEST

EAST

SOUTH

Russell

KANSAS



Sec. 17 Twp. 14 R. 13W

Well No. #3 Ehrlich "C" Farm

Murfin Drlg. Company

Contractor


Ft. from N. Line

990 Ft. from S. Line

Ft. from E. Line

990 Ft. from W. Line

NE SW NW

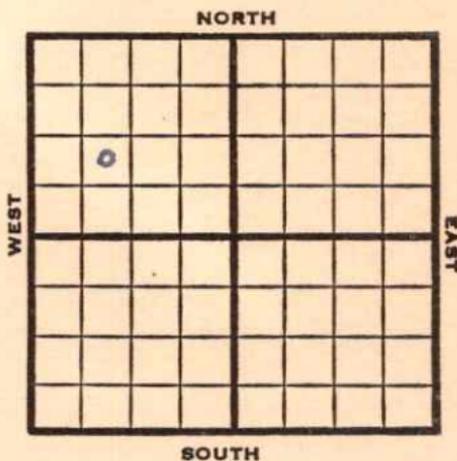

1952 **El v. 1846'** REPORT

11/19 Cellar & Pits

11/27 Drlg. 347'

12/4 NR

12/11 12" @ 345 Anhy 812 8" @ 825 Ø1725

12/18 Tarkio 2377 TD 2393 7" @ 2393

12/25 " " " "

1953

1/7 Spud 11-22-52 Oil well TD 2401'
 12" @ 345 **Anhy 812'** 8" @ 825
Tarkio 2377' TD 2393' 23 GO 4 hr.
 7" @ 2393 DD 2401 st-frac.
 S/4 BOPH Comp. 25 BOPD

COMPLETED

