


Section 11 Township 15 Range 14-W

Well No. 4 Landon

Company J. J. Hall

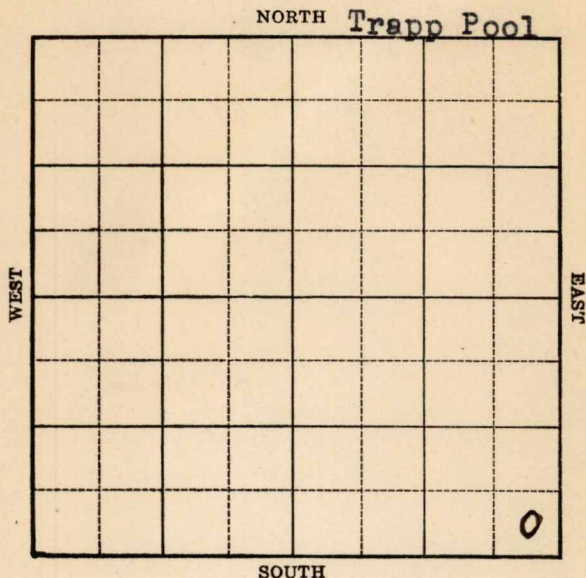

Sec. 11 Twp. 15 R. 14-W

Well No. #4 Landon Farm

J. J. Hall Company


(Trapp)

_____ Ft. from N. Line

330 Ft. from S. Line

330 Ft. from E. Line

_____ Ft. from W. Line

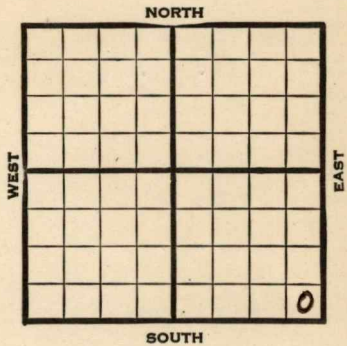

Elev. 1886

1939	REPORT
5/10	Cellar.
5/19	Cable rig.
5/26	" "
6/1	" "
6/8	" "
6/16	" "
6/23	Rigging up.
6/29	Drlg. 440'
7/6	15" - 573' Anhy. 873'
	12" - 882' Drlg.
7/13	Drlg. 1690'
7/20	2240' run 10".
7/27	10" - 2262' Drlg. 2540'
8/3	2605' U.R. 10".
8/10	" " "
8/17	10" - 2600' Drlg. 2950'
8/24	Dodge 3064' Lans. 3075'
	S.O. 3185-90' S.O. 3324-28'
	8" - 3328' C.O.
	OVER

1939

8/31 Arb. 3377' T.D. 3382' Water.
Plug back.

9/7 P. B. & 8" - 3323' T.D. 3336'

9/13 Arb. 3377'

8" - 3323'

T.D. 3382'

Plugged back.

Drilled to 3345'

7000 acid.

Potential 2085 bbls., pump.

COMPLETED

Map No. _____ Sec. 11 Twp. 15 R. 14W

Well No. 4 Landon

J. J. Hall Company

Contractor

FIRST REPORT
SE/C

SECTION PLAT

			0

_____ Ft. from N. Line

330 Ft. from S. Line

330 Ft. from E. Line

_____ Ft. from W. Line

TRAPP POOL

Location _____

Rig up _____

Drilling and Remarks:

Cellar

RECORD

Cased _____ in., _____ ft.

Sand _____

Gas _____

Oil _____

Total Depth _____

PRODUCTION

1st 24 hrs. Nat. _____

1st 24 hrs. after shot _____

Gas _____ Cu. Ft.

Dry Hole _____

Abandoned _____

Date

MAY 10 1939

19

S. J. LEWIS

Scout

Map No. 73 Sec. 11 Twp. 15 R. 14W

Well No. 4 London

J. J. Hall

Company

Contractor

COMPLETED

SE/C

 Ft. from N. Line

330 Ft. from S. Line

330 Ft. from E. Line

 Ft. from W. Line

SECTION PLAT

TRAPP POOL

Location

Rig up

Drilling and Remarks:

Cu 43377
8" C 3323
P.B.
Drilled to 3345
7000 acid
Pump 2085

RECORD

Cased in., ft.

Sand

Gas

Oil

Total Depth 3382

PRODUCTION

1st 24 hrs. Nat.

1st 24 hrs. after shot

Gas Cu. Ft.

Dry Hole

Abandoned

Date

SEP 13 1939 19

S. J. LEWIS Scout