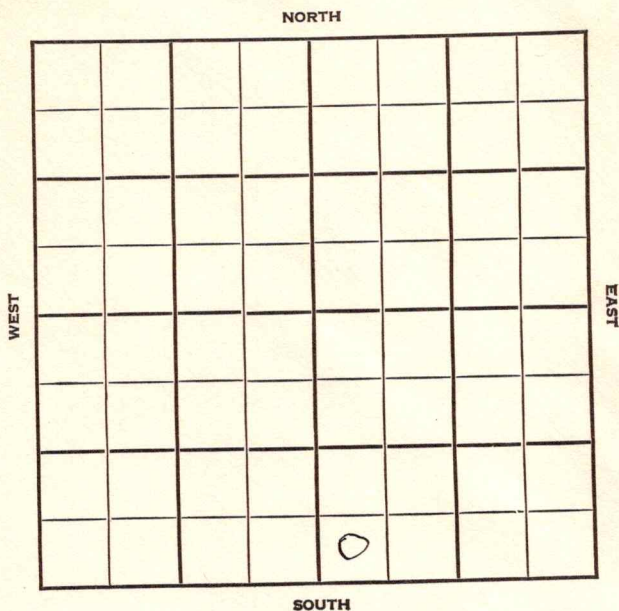


KANSAS Ellis

Section 29 Township 13 Range 19WWell No. 1 BemisCompany Herndon Drlg.

Sec. 29 Twp. 13 R. 19-W

Well No. #1 Bemis Farm

Herndon Drlg Company

Wildcat


 Ft. from N. Line

330 Ft. from S. Line

 Ft. from E. Line

330 Ft. from W. Line

SW SE

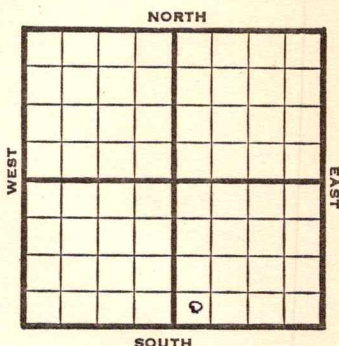

1948 **Elev. 2208'** REPORT

8/4 Location

8/11 8" @ 153'

Lansing 3497'

Conglomerate 3805'

8/18 Drlg 3858' in cong.

Arb. 3872'

TD 3932

5" @ 3932'

8/25 "

9/1 Plug 3720'

26 shots 3689-3700 - 500 acid water

9/8 **Arb. 3872'**

5" @ 3932'

TD 3932'

Perf Lans.

ABANDONED

