


Section 12 Township 15 Range 14-W
 Well No. #15 Eichman
 Company Cities Service

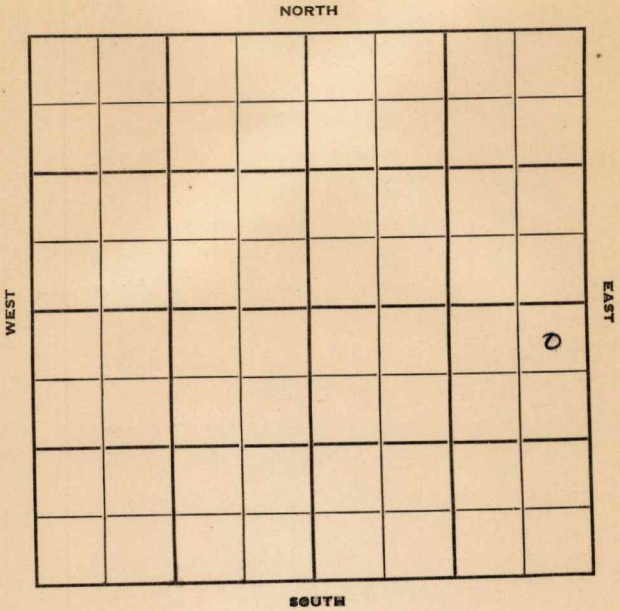

KANSAS

Russell

Sec. 12 Twp. 15 R. 14-W ✓

Well No. #15 Eichman Farm

Cities Service

Company

Trapp Pool


330 Ft. from N. Line

Ft. from S. Line

330 Ft. from E. Line

Ft. from W. Line

NE NE SE

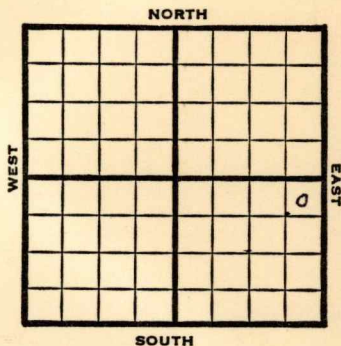

1950

Elev 1879'

REPORT

2/22

Location

3/15

TD 3381 in Cong

8" @ 527'

Heeb 2999'

Lans 3064'

Cong 3329'

D&A

Aband.

ABANDONED

Kansas

Trapp Pool

Map No. _____ Sec. 12 Twp. 15 R. 14WWell No. 15 Eichman

Cities Service

Company

Contractor

NE NE SE

SECTION PLAT

330 Ft. from N. Line

_____ Ft. from S. Line

330 Ft. from E. Line

_____ Ft. from W. Line

			0

Russell County

Location _____ X

Rig up _____

Drilling and Remarks:

RECORD

Cased _____ in., _____ ft.

Sand _____

Gas _____

Oil _____

Total Depth _____

PRODUCTION

1st 24 hrs. Nat. _____

1st 24 hrs. after shot _____

Gas _____ Cu. Ft.

Dry Hole _____

Abandoned _____

Date

FEB 22 1950 19

J. E. TYRA Scout

Kansas

Map No. _____ Sec. 12 Twp. 15 R. 14WWell No. 15 Eichman

Cities Service

Company

Contractor

NE NE SE

E. 1879
SECTION PLAT

	ABANDONED		
.			o

330 Ft. from N. Line

_____ Ft. from S. Line

330 Ft. from E. Line

_____ Ft. from W. Line

Russell County

Location _____

Rig up _____

Drilling and Remarks:

8" @ 527

Hulb 2999

Lans 3064

Cong 3329

D & A

RECORD

Cased _____ in., _____ ft.

Sand _____

Gas _____

Oil _____

Total Depth 3381 in Cong

PRODUCTION

1st 24 hrs. Nat. _____

1st 24 hrs. after shot _____

Gas _____ Cu. Ft.

Dry Hole _____

Abandoned _____

Date

MAR 15 1950

19

J. E. TYRA

Scout