

KANSAS

Form 51—5M—7-39—Palace

Russell

Section 12 Township 15 Range 14-W

Well No. #3 Eichman "A"


Company Cities Service Oil

NORTH

Trapp Pool

WEST

EAST

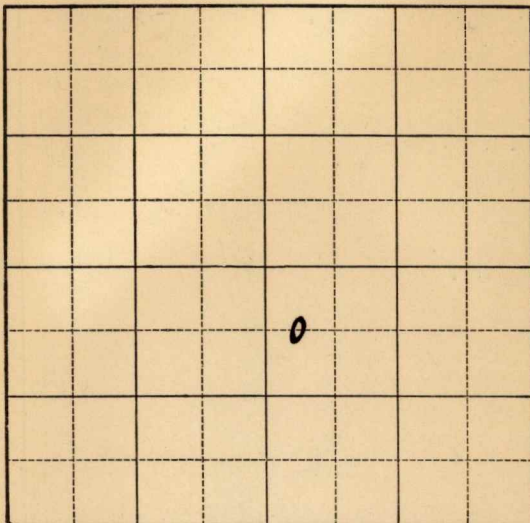

SOUTH

KANSAS

Russell

Sec. 12 Twp. 15 R. 14-WWell No. #3 Eichman "A" Farm

Cities Service Oil


Company

(Trapp)

660 Ft. from N. Line

Ft. from S. Line

Ft. from E. Line

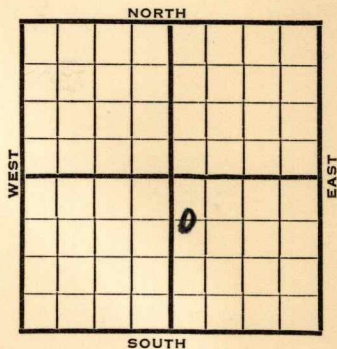330 Ft. from W. Line

Elev. 1875

1940

REPORT

5/22

Location

5/29

10" - 349' Drlg. 2043'

6/6

Lans. 3060' T.D. 3085'

7" - 3084' RUST.

6/12

Lans. 3056'

7" - 3080'

T.D. 3102'

1000 acid.

Potential 1928 bbls., pump.

COMPLETED

Map No. 73 Sec. 12 Twp. 15 R. 14WWell No. 3 Eichman "A"Cities Service Oil Company

Contractor

FIRST REPORT

C W L NW SE

660 Ft. from N. Line Ft. from S. Line Ft. from E. Line330 Ft. from W. Line

TRAPP POOL

SECTION PLAT

		0	

Location XRig up

Drilling and Remarks:

RECORDCased in., ft.Sand Gas Oil Total Depth **PRODUCTION**1st 24 hrs. Nat. 1st 24 hrs. after shot Gas Cu. Ft.Dry Hole Abandoned

Date

MAY 22 1940 19S. J. LEWIS Scout

Map No. 72 Sec. 12 Twp. 15 R. 14WWell No. 3 Eichman "A"

Cities Service Oil Company

Contractor

COMPLETED

C W L NW SE

660 Ft. from N. Line

_____ Ft. from S. Line

_____ Ft. from E. Line

330 Ft. from W. Line

TRAPP POOL

SECTION PLAT

		o	

Location _____

Rig up _____

Drilling and Remarks:

*Lans 3056**7" C 3086**1000 acid**Pump 1928 P.D.*

RECORD

Cased _____ in., _____ ft.

Sand _____

Gas _____

Oil _____

Total Depth 3102

PRODUCTION

1st 24 hrs. Nat. _____

1st 24 hrs. after shot _____

Gas _____ Cu. Ft.

Dry Hole _____

Abandoned _____

Date

JUN 12 1940 19S. J. LEWIS Scout