

KANSAS


Russell

Form 51—5M—7-40—Palace

Section 12 Township 15 Range 14 -W

Well No. #4 Eichman "A"

Company Cities Service Oil

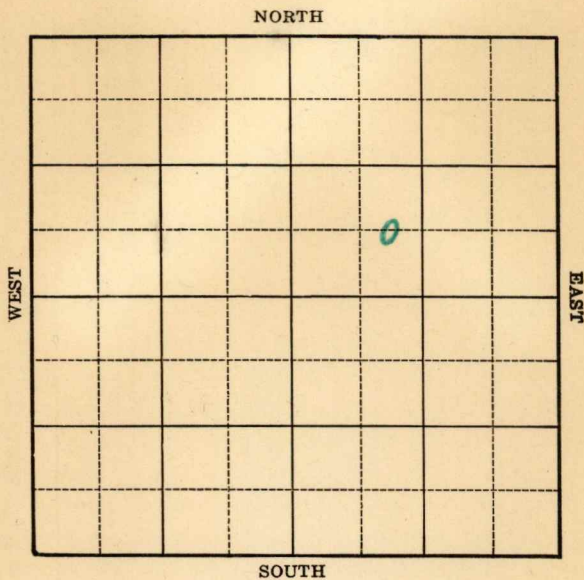

Map No. 73 Sec. 12 Twp. 15 R. 14WWell No. 4 Eichman "A"Cities Service Oil Company

Contractor

FIRST REPORT
C E L SW NE

SECTION PLAT

 Ft. from N. Line660 Ft. from S. Line Ft. from E. Line990 Ft. from W. Line

TRAPP POOL

Location XRig up

Drilling and Remarks:

RECORD

Cased in., ft.Sand Gas Oil Total Depth

PRODUCTION

1st 24 hrs. Nat. 1st 24 hrs. after shot Gas Cu. Ft.Dry Hole Abandoned

Date

DEC 23 1940 19S. J. LEWIS Scout

Map No. 73 Sec. 12 Twp. 15 R. 14WWell No. 4 Eichman "A"

Cities Service Oil Company

Contractor

COMPLETED

SECTION PLAT

C E L S W N E

____ Ft. from N. Line

660 Ft. from S. Line

____ Ft. from E. Line

990 Ft. from W. Line

		o	

TRAPP POOL

Location _____

Rig up _____

Drilling and Remarks:

*Cor 83317**5" @ 3319**2000 acid**Pump 324 P.X.**39° Gr.*

RECORD

Cased _____ in., _____ ft.

Sand _____

Gas _____

Oil _____

Total Depth 3331

PRODUCTION

1st 24 hrs. Nat. _____

1st 24 hrs. after shot _____

Gas _____ Cu. Ft.

Dry Hole _____

Abandoned _____

Date

S. J. LEWIS Scout

JAN 29 1941 19