


Section 12 Township 15 Range 14-W

Well No. #10, Eichman "A"

Company Cities Service Oil Company

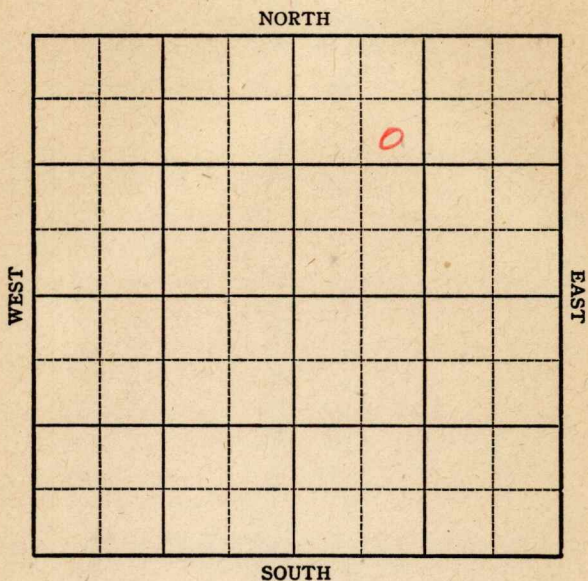

KANSAS

Russell county

Sec. 12 Twp. 15 R. 14-W

Well No. #10, Eichman "A" Farm


Cities Service Oil Company Company
Trapp Pool

990' Ft. from N. Line

_____ Ft. from S. Line

_____ Ft. from E. Line

990' Ft. from W. Line

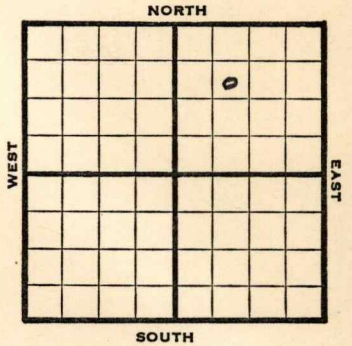

SE NW NE

1946. **Elev. 1844'** REPORT

12/18 Drlg. 275'

1947

1/4 8" @ 345'
Drlg 3344'

1/8 **Lans 3045'**
Congl 3316'
ReArb 3341'
TD 3344'

ABANDONED

Map No. _____ Sec. 12 Twp. 15 R. 14W

Well No. 10 Eichman "A"

Cities Service

Company

FIRST REPORT

Contractor

SE NW NE

SECTION PLAT

990 Ft. from N. Line

_____ Ft. from S. Line

_____ Ft. from E. Line

990 Ft. from W. Line

		o	

Russell County

Location _____

Rig up _____

Drilling and Remarks:

drlg. 275'

RECORD

Cased _____ in., _____ ft.

Sand _____

Gas _____

Oil _____

Total Depth _____

PRODUCTION

1st 24 hrs. Nat. _____

1st 24 hrs. after shot _____

Gas _____ Cu. Ft.

Dry Hole _____

Abandoned _____

Date

DEC 1 8 1946 19

S. J. LEWIS

Scout

