


SECTION 30 TOWNSHIP 13S RANGE 19W

WELL NO. #1 Mary Orth

COMPANY Texas Co.

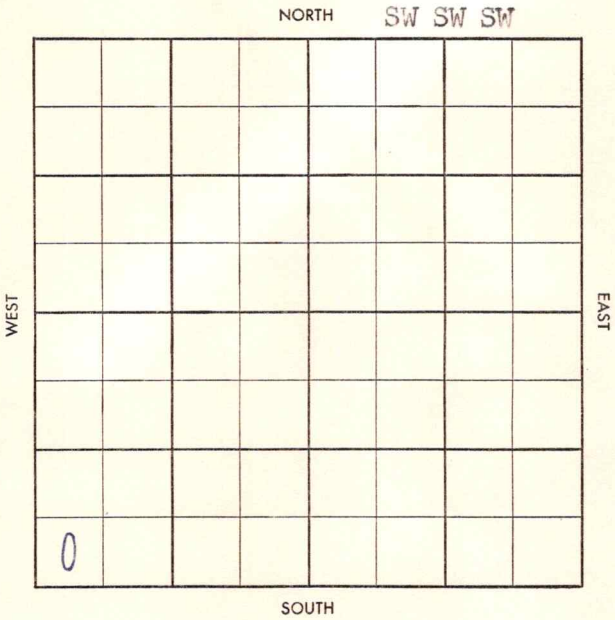

CO. ~~Ellis~~ ELEV. ~~22130~~  
SEC. 30 TWP. ~~13~~ RGE. 19W  
COMPANY Texas Co. NO. 1

COMPLETE  
JAN 29 '58

FARM Mary Orth

LOC. SW SW SW  
Log tops

TP 3199
H 3457
TR 3479
L 3499
BKC 3745
C 3798
Arb 3833
TP 3856

GEOL. \_\_\_\_\_  
CONTR. Stickle Drlg.  
POOL Irvin  
SPUD 12-23-57  
MIR DEC 26 '57 10" 500/300  
JAN 2 '58 3245  
JAN 8 '58 7" 3838/175

run log woc  
JAN 15 '58 CO  
\$ 50 B0 NW

13 hrs 37° gr wopot

JAN 22 '58 JAN 29 '58

arb op 3838-56

Dhy P 151 B00d NW  
37.1° gr

CO.  
LSE.  
NO.  
SEC.  
TWP.  
RGE.

