
Russell county

FORM 51 5M 6-46 PETROL KANSAS

Section 12 Township 15 Range 14-W

Well No. #8, Eickman "A"

Company Cities Service Oil Company

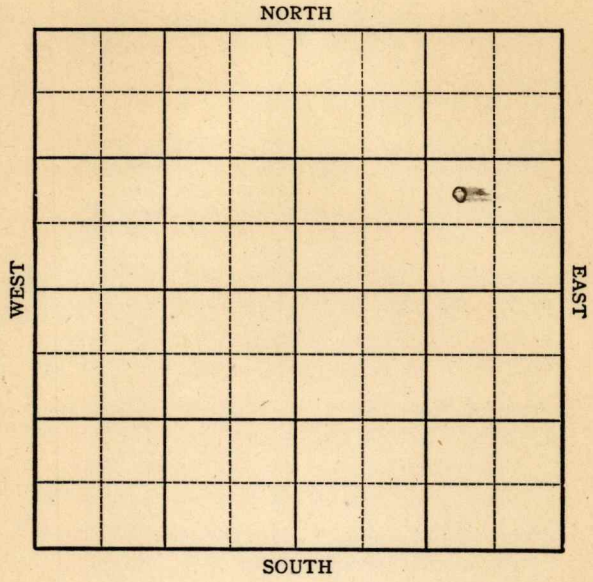

FORM 252-A
5M 12-45 PETROL

KANSAS

Russell County

Sec. 12 Twp. 15 R. 14W

Well No. #8 Eickman "A" Farm

Cities Service Company

Trapp


____ Ft. from N. Line

990 Ft. from S. Line

990 Ft. from E. Line

____ Ft. from W. Line

NW SE NE

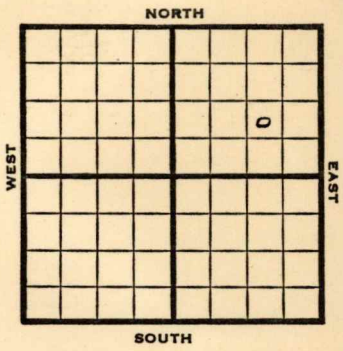

1946 1872 REPORT

9/18 Location

9/24 8" @ 337
Drlg 2415'

10/1 Arb 3320'
TD 3322
4" @ 3320, RUST

10/8 " "

10/15 TD 3329'
500 acid
Pump 110 oil in 9 hrs

10/23 Arb 3320'
4" @ 3320'
500 Acid
Pump 361 POT
TD 3329'
Grav. 41

COMPLETED

FORM 56 200 BKS. 1-44 PETROL

KANSAS Kansas Pool Name Trapp

Map No. 73 Sec. 12 Twp. 15 R. 14W


Well No. 8 Eickman "A"

Cities Service Company

FIRST REPORT Contractor

NW SE NE

SECTION PLAT

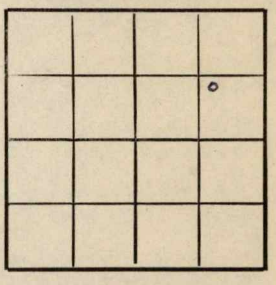

Ft. from N. Line

990 Ft. from S. Line

990 Ft. from E. Line

Ft. from W. Line

Russell County

Location X

Rig up

Drilling and Remarks:

RECORD

Cased in., ft.

Sand

Gas

Oil

Total Depth

PRODUCTION

1st 24 hrs. Nat.

1st 24 hrs. after shot

Gas Cu. Ft.

Dry Hole

Abandoned

Date

SEP 18 1946 19 S. J. LEWIS Scout

Form 26 200 Bks. 10-46 Petrol KANSAS Trapp Pool

Map No. 73 Sec. 12 Twp. 15 R. 14W

Well No. 8 Eickman "A"


Cities Service Company

COMPLETED Contractor

NW SE NE

El. 1872

SECTION PLAT

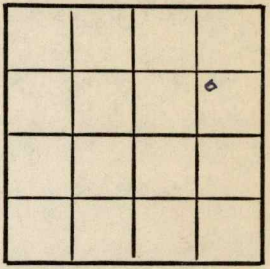

____ Ft. from N. Line

990 Ft. from S. Line

990 Ft. from E. Line

____ Ft. from W. Line

Russell County

Location

Rig up

Drilling and Remarks:

Cir of 3320
4" @ 3320
500 acid
Pump 36 Bbl.

#1 ~~2~~ 24

RECORD

Cased ____ in., ____ ft.

Sand

Gas

Oil

Total Depth 3329

PRODUCTION

1st 24 hrs. Nat.

1st 24 hrs. after shot

Gas ____ Cu. Ft.

Dry Hole

Abandoned

Date

OCT 23 1946 19

S. J. LEWIS Scout