

KANSAS
RussellSection 34 Township 14 Range 13WWell No. 2-1 Owens "B" per Res-Dr1Company Shields et al

Hall-Gurney Pool

NORTH

0							

WEST

EAST

SOUTH

HOT FILE

Sec. 34 Twp. 14 R. 13-W ✓

Well No. 2 #1 Owens "B" Farm

Shields et al Company

Hall-Gurney Pool

NORTH




330 Ft. from N. Line

Ft. from S. Line

Ft. from E. Line

330 Ft. from W. Line

NW SW

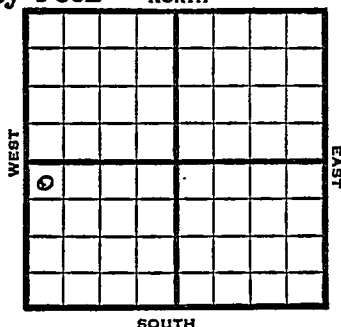

1948 Eli 1698' REPORT

10/6 8" @ 205'
Anhy 615
Drlg 2568'
10/13 Lansing 2829' 47'
TD 2847'
5" @ 2847'
10/19 TD 2874' SO
10/27 TD 2874'
Lansing 2829'
5" @ 2847'
11000 acid
Pump 336 oil Pot
40⁹ Gr.

Comp
COMPLETED

Map No. _____ Sec. 34 Twp. 14 R. 13WWell No. 2 1 Owens "B"_____
Shields et al. _____ Company

FIRST REPORT _____ Contractor

NW SW

330 Ft. from N. Line_____
Ft. from S. Line_____
Ft. from E. Line330 Ft. from W. Line

SECTION PLAT

0			

Russell County

Location _____

Rig up _____

Drilling and Remarks:

8" @ 205

Anhy 615

drlg. 2 568

RECORD

Cased _____ in., _____ ft.

Sand _____

Gas _____

Oil _____

Total Depth _____

PRODUCTION

1st 24 hrs. Nat. _____

1st 24 hrs. after shot: _____

Gas _____ Cu. Ft.

Dry Hole _____

Abandoned _____

Date

OCT 6 1948 19 _____ S. J. LEWIS Scout

Kansas

Map No. 72 Sec. 34 Twp. 14 R. 13WWell No. 2 Owens "B"

Shields et al.

Company

COMPLETE


Contractor

NW SW

E11698
SECTION PLAT330 Ft. from N. Line

Ft. from S. Line

Ft. from E. Line

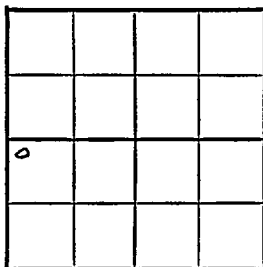330 Ft. from W. Line

Russell County

Location

Rig up

Drilling and Remarks:

Loss 2829
 5" @ 2847
 11000 and
 Pump 36 oil
 402 1/2

RECORD

Cased _____ in., _____ ft.

Sand _____

Gas _____

Oil ☒Total Depth 2874

PRODUCTION

1st 24 hrs. Nat. _____

1st 24 hrs. after shot _____

Gas _____ Cu. Ft.

Dry Hole _____

Abandoned _____

Date

OCT 27 1948

19

S. J. LEWIS

Scout