


Section 6 Township 14 Range 13 W

Well No. # 1 Witt

Company Dizdar Oil

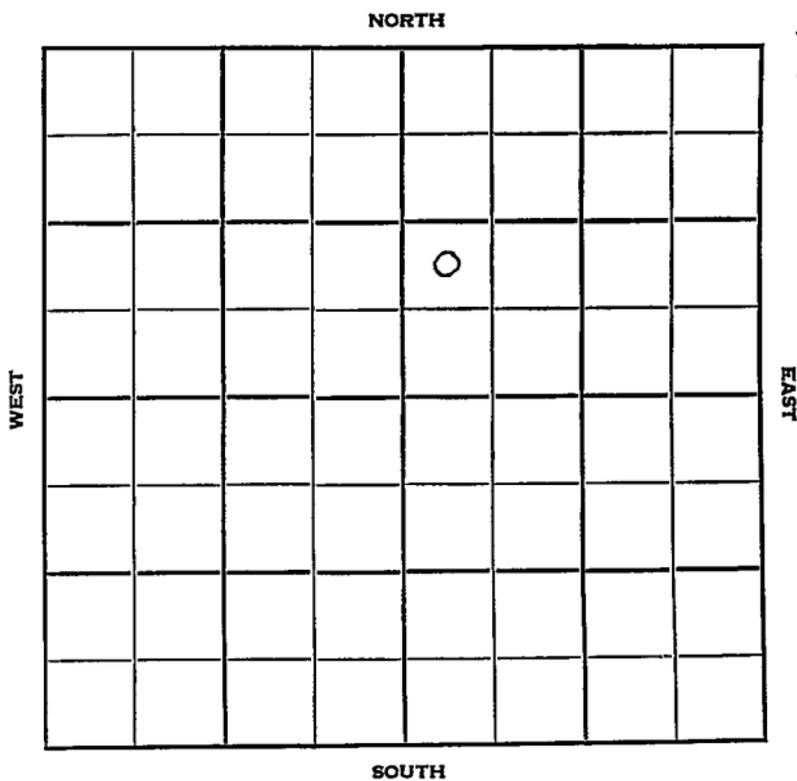

Sec. 6 Twp. 14 R. 13W ✓

Well No. #1 Witt Farm

Dizard Oil Company

Wildcat Contractor


Ft. from N. Line

990' Ft. from S. Line

Ft. from E. Line

330' Ft. from W. Line

NW SW NE

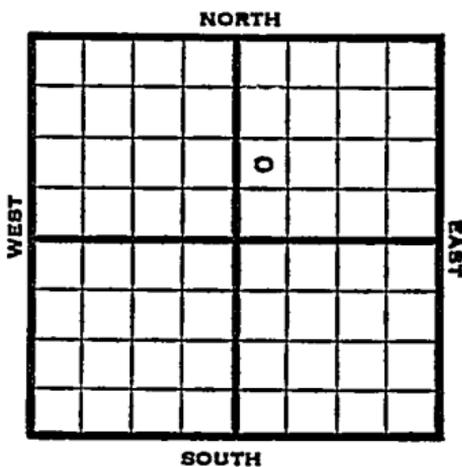

1951 Elev. 1865' REPORT

4/25 Location  
 5/16 Spud 4-27-51  
 D & A TD 3353' 8" @ 127  
 Anhy 830-67' Tarkio 2430'  
 DST 2415-50 open 1/2 hr. rec 30' salty  
 mud Heeb 2960' Dodge 2978'  
 Lans. 3025'  
 DST 3201-21 open 1 hr rec 8' mud, tr  
 oil. B KC 3230' Cong 3314'  
 Arb. 3343' TD 3353' D & A

ABANDONED




County Russell State Kansas

Sec. 6 (Blk. Twp.) 14 (Sur. Rge.) 13W Map No.

Operator Dizard Oil

Well No. 1 Farm Witt

Elev. 1865 Location NW SW NE

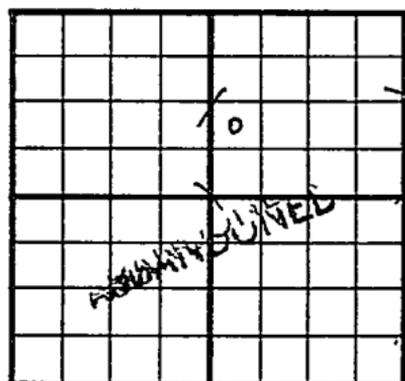

990 Ft. From S Line NE

330 Ft. From W Line Quarter

Ist. Report

Completion MAY 16 1951

Remarks Wildcat

Spudding Date 4-27-51

Drlg. Data D & A TD 3353

8" @ 127- Anhy 830-67 Tarkio 2430

DST 2415-50 open  $\frac{1}{2}$  hr. Rec. 30' salty  
mud Heeb. 2960 Dodge 2978

Lans. 3024 DST 3201-21 open 1 hr.

Rec. 8' mud tr. oil B KC 3230

Cong. 3314 Arb. 3343 TD 3353

D & A

J. E. TYRA