

KANSAS


FORM 51 5M 6-46 PETROL

Russell county

Section 12 Township 15 Range 14-W

Well No. #7, Eickman "A"

Company Cities Service Oil Company

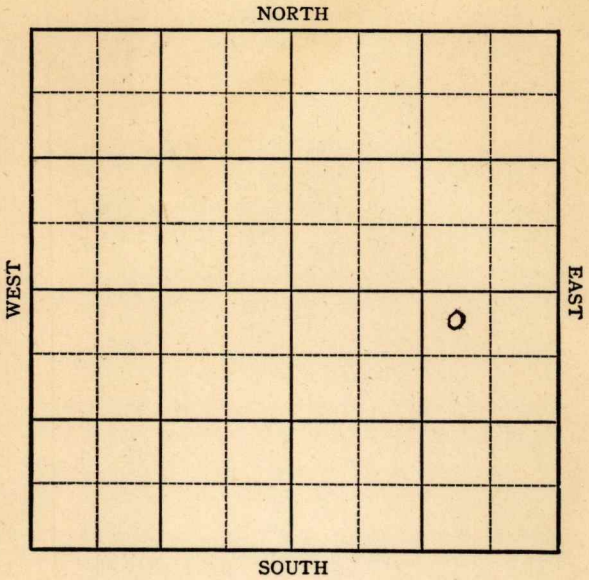

KANSAS

Russell County



Sec. 12 Twp. 15 R. 14W

Well No. #7 Eickman "A" Farm

Cities Service Company

Trapp
330

Ft. from N. Line


Ft. from S. Line

990

Ft. from E. Line

Ft. from W. Line

NW NE SE

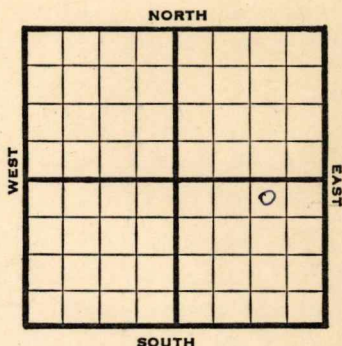

1946

Elev. 1881'

REPORT

7/31

Location

8/6

8" @ 332 WOC

8/13

Drlg 3274'

8/20

Lans 3058'

Arb 3333-36

TD 5" @ 3335 RUST

8/24

SLM 3336-40

Arb 3337

5" @ 3 339'

TD 3253

59 shots 3093-3106-1000 acid

Swab 72oil in 12 hrs.

9/5

Lans 3058'

Arb 3333'

5" @ 3339'

Perf Lans

3000 acid

Pump 241 Pot

Grav 41

TD 3553'

COMPLETED

KANSAS

Kansas

Pool Name TrappMap No. 73 Sec. 12 Twp. 15 R. 14WWell No. 7 Eickman "A"

Cities Service

Company

FIRST REPORT

Contractor

NW NE SE

SECTION PLAT

330 Ft. from N. Line Ft. from S. Line990 Ft. from E. Line Ft. from W. Line

			0

Russell County

RECORD

Location XCased in., ft.Rig up Sand

Drilling and Remarks:

Gas Oil Total Depth

PRODUCTION

1st 24 hrs. Nat. 1st 24 hrs. after shot Gas Cu. Ft.Dry Hole Abandoned

Date

JUL 3 1 1946 19S. J. LEWIS

Scout

Pool Name TrappKansasMap No. 73 Sec. 12 Twp. 15 R. 14WWell No. 7 Eichman "A"

Cities Service

Company

COMPLETED

Contractor

NW NE SE

SECTION PLAT

330 Ft. from N. Line

Ft. from S. Line

990 Ft. from E. Line

Ft. from W. Line

			0

Russell County

RECORD

Location

Cased in, ft.

Rig up

Sand

Drilling and Remarks:

Gas

Oil

Total Depth 3553

PRODUCTION

1st 24 hrs. Nat.

1st 24 hrs. after shot

Gas Cu. Ft.

Dry Hole

Abandoned

Date

SEP 5 1946 19

S. J. LEWIS

Scout

Lans 3058.
Ar 3333
5" 3339.
Prof Lans.
3000 acd
Pump 24/10
412-44