


DX 78-1 Russell

KANSAS

Section 12 Township 15 Range 14W

Well No. #1 Tittle

Company Kim Oil

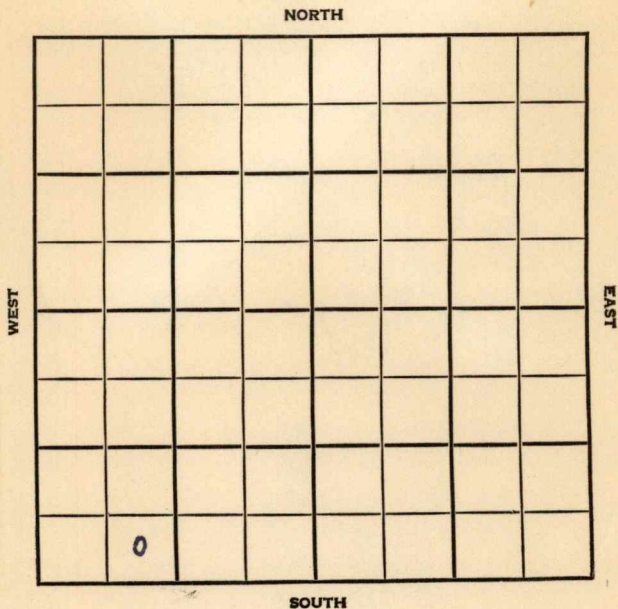

Russell

KANSAS

SEC.	TWP.	R.
12	15	14W

WELL NO. #1 Tittle FARM

COMPANY Kim Oil

CONTRACTOR


Trapp Pool

Ft. from N. Line

330 Ft. from S. Line

Ft. from E. Line

990 Ft. from W. Line

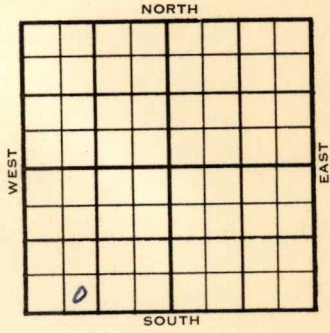

SE SW SW

	ELEVATION	REPORT
1954	1877'	
11/11 1955		Drlg.
1/5		Spud 11-6-54 D & A TD 3375' 8-5/8" @ 207' KC 3071', Arb. 3373' TD 3375' 5" @ 3375' CO to 3150' 32/ 3142-50 2 goph CO to 3155 32/ 3141'-49' 1500 A 2 bwph D & A

ABANDONED

