


FORM 51 25M 3-49 PETROL

Ellis

Section 31 Township 13 Range 19W

Well No. 5 G. E. Reidel

Company Texas Company

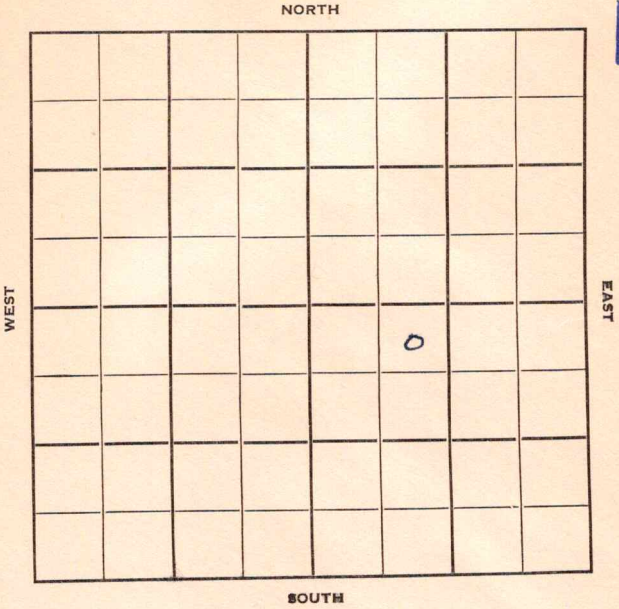

Ellis

KANSAS
19W

Sec. 31 Twp. 13 R. 19W

Well No. #5 G. E. Reidel Farm

Texas Company Company

Contractor


330 Ft. from N. Line

Ft. from S. Line

Ft. from E. Line

990 Ft. from W. Line

NE NW SE

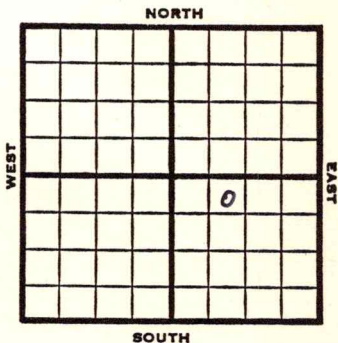

1953 **Elev. 2271'** REPORT

- 1/14 Spud 1-11-53
Drlg. 279'
- 1/22 10" @ 278
Drlg. 3411'
- 1/29 **Top 3260, Heeb 3521, Lans 3563, Arb. 3907**
RTD 3913
7" @ 3905
- 2/4 **CO 3913'** 15 GO 3 hrs. 500 A
S/48 BOPH 4 hrs.
- 2/11 Spud 1-11-53
OilWell
TD 3913
10" @ 278
Top 3260, Heeb 3521, Lans 3563, Arb 3907
TD 3913
7" @ 3905, CO to 3913, 15 go
3 hrs., 500A
S/48 boph 4 hrs.
Comp. 822 bopd

COMPLETED

County Ellis State Kansas

Sec. 31 (Blk. 13 (Sur. 19W (Twp.) 19W Map No.

Operator Texas Company

Well No. 5 Farm G. E. Reidel

Elev. _____ Location NE NW SE

330 Ft. From N Line SE

990 Ft. From W Line Quarter

1st. Report JAN 14 1953

Completion _____

Remarks _____

Spudding Date 1-11-53

Drlg. Data

drlg. 279

