


Section 15 Township 16 Range 14-W

Well No. #1 Poop

Company Stearns & Vernon

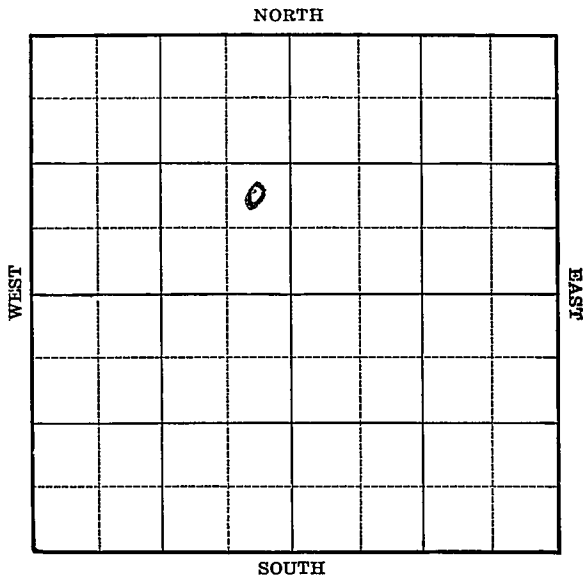

Sec. 15 Twp. 16 R. 14-W

Well No. #1 Poop Farm

Stearns & Vernon Company

(Trapp)


           Ft. from N. Line

99.0 Ft. from S. Line

330 Ft. from E. Line

           Ft. from W. Line

Elev. 1698

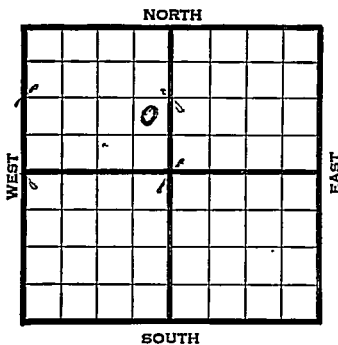

	REPORT
1941	
2/12	Cable.
2/20	"
2/27	"
3/6	Spud.
3/13	15½" - 397' Drlg. 536'
3/20	13" - 585' Anhy 867'
	Drlg. 900'
3/27	10" - 875' Drlg. 1725'
4/2	Neva 2190' Drlg. 2335'
4/10	8" - 2549' Drlg. 2725'
4/18	Topeka 2820' Lans. 3125'
	7" - 3135' Drlg. 3152'
4/23	Arb. 3370'
	T.D. 3420'
	Water.
	ABANDONED



