

Section 17 Township 14 Range 13-W

Well No. #4 Rein


Company Elreco

NORTH

12

WEST

EAST

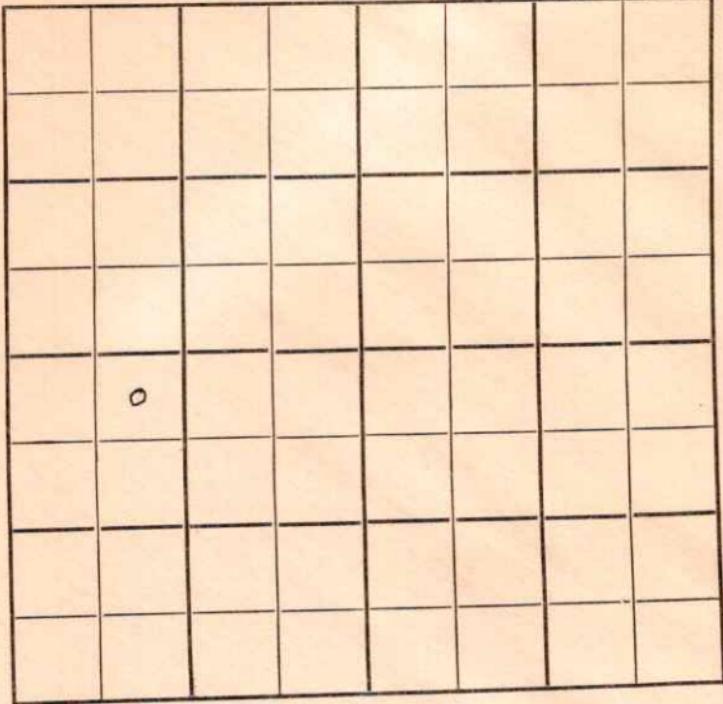

SOUTH

Russell

KANSAS

Sec. 17 Twp. 14 R. 13W

Well No. #4 Rein Farm

Elreco Company

Murfin Drlg. Contractor


330' Ft. from N. Line

_____ Ft. from S. Line

_____ Ft. from E. Line

990' Ft. from W. Line

NE NW SW

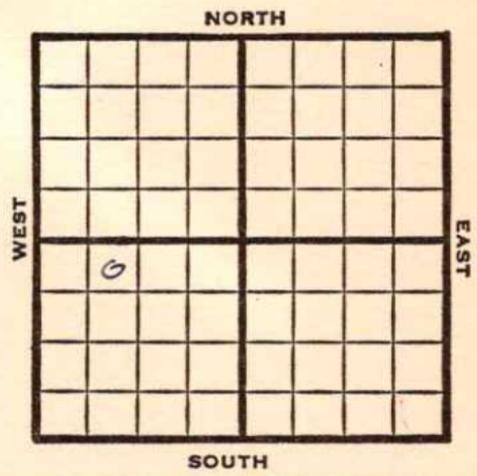

1950

Elev 1833

REPORT

6/21

Rig up

8/23

12" @ 370

10" @ 490

Anhy 805

8" @ 810

Tarkio 2361-95

5" @ 2361

S/13 bo 10 hr

Comp 30 bopd TD 2395

Completed

COMPLETED

Kansas

Map No. _____ Sec. 17 Twp. 14 R. 13WWell No. 4 Rein_____ Elreco _____ Company_____ Murfin Drllg. _____ Contractor

NE NW SW

SECTION PLAT

330 Ft. from N. Line

_____ Ft. from S. Line

_____ Ft. from E. Line

990 Ft. from W. Line

o			

FIRST REPORT

Russell County

Location _____

Rig up _____ x

Drilling and Remarks:

RECORD

Cased _____ in., _____ ft.

Sand _____

Gas _____

Oil _____

Total Depth _____

PRODUCTION

1st 24 hrs. Nat. _____

1st 24 hrs. after shot _____

Gas _____ Cu. Ft.

Dry Hole _____

Abandoned _____

Date

JUN 21 1950 19 J. E. TYRA Scout

