


Section 8 Township 14 Range 13W

Well No. 3 Fink

Company Jayhawk Well Service

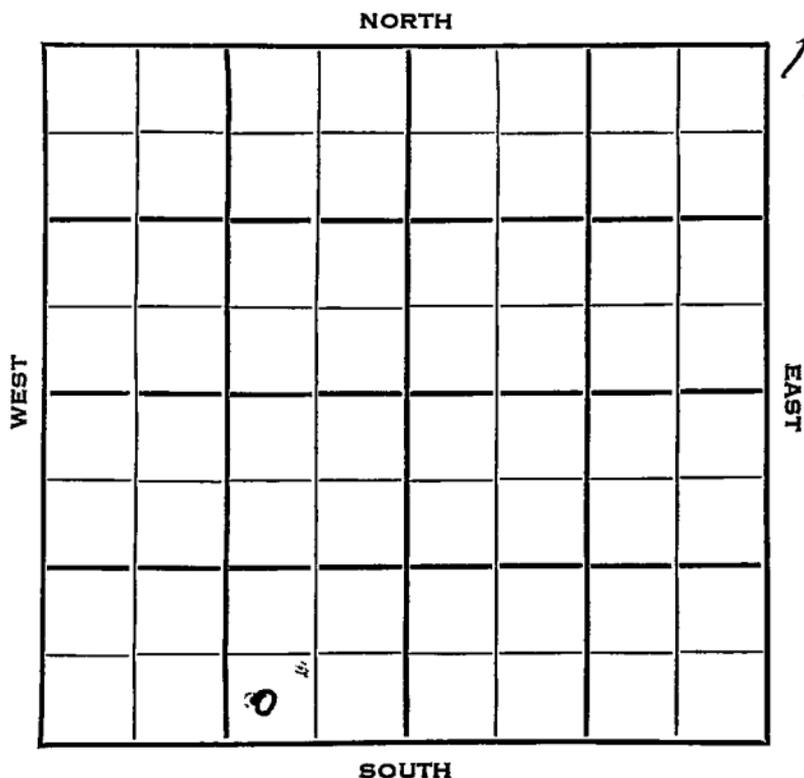

Russell KANSAS

SEC. 8	TWP. 14	R. 13 W	✓
-----------	------------	------------	---

WELL NO. # 3 Fink FARM

COMPANY Jayhawk Well Service

CONTRACTOR


Hall-Gurney Pool

\_\_\_\_\_ Ft. from N. Line

330 \_\_\_\_\_ Ft. from S. Line

990 \_\_\_\_\_ Ft. from E. Line

\_\_\_\_\_ Ft. from W. Line

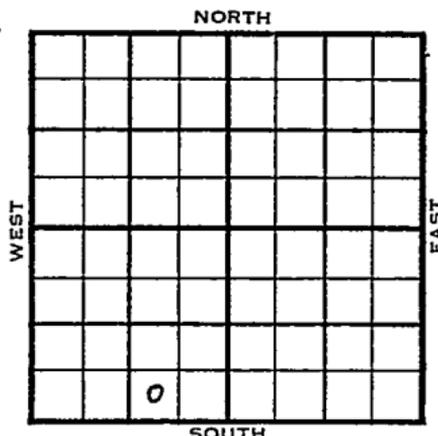

SW SE SW

1954	ELEVATION 1867'	REPORT
------	--------------------	--------

- 2/24 Cellar & Pits
- 3/10 13" @ 255' 10" @ 515'  
Drlg. 720'
- 3/17 Anhy 830' 8" @ 843'  
Drlg. 1885'
- 3/24 pud 3-4-54  
D&A  
TD 2485'  
13" @ 255'  
10" @ 515'  
Anhy 830',  
8" @ 843'  
Tarkio 2404'  
TD 2485'  
Hole Caved  
D&A

**ABANDONED**



County Russell State Kansas  
 Sec. 8 (Blk. 14) (Sur. 13W) (Twp.) Map No.  
 Operator Jayhawk Well Service  
 Well No. 3 Farm Fink  
 Elev. 1867 Location SW SE SW

<b>ABANDONED</b>									

330 Ft. From S Line SW  
990 Ft. From E Line Quarter  
 Ist. Report \_\_\_\_\_  
 Completion MAR 24 1954  
 Remarks Hall-Gurney Pool  
 Spudding Date 3-4-54

Drlg. Data D & A TD 2485  
13" @ 255 10" @ 515 Anhy 830  
8" @ 843 Tarkio 2404 TD 2485

hole caved  
D & A