

FORM 51 25M 3-49 PETROL Russell

Section 17 Township 14 Range 13W

Well No. #5 Rein (C)


Company Murfin Drlg.

NORTH

14

WEST

EAST

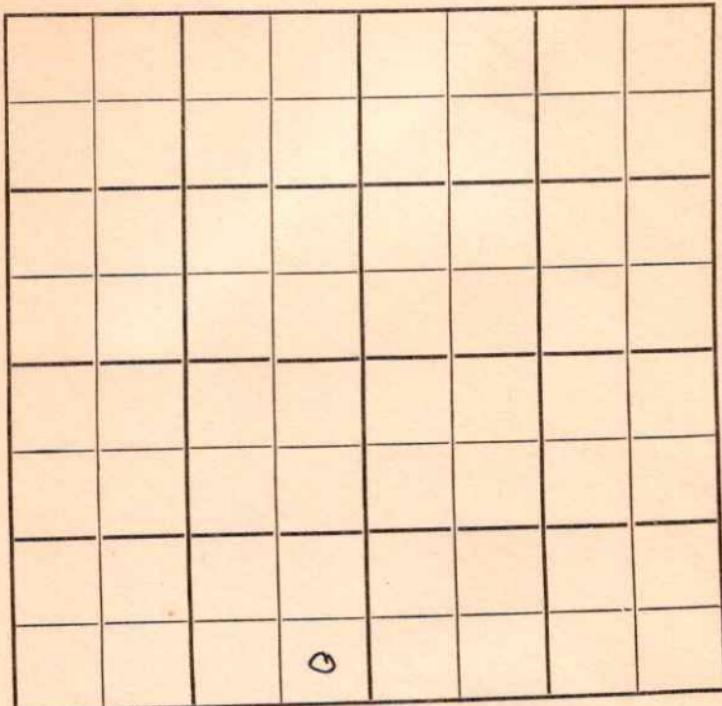

SOUTH

Russell

KANSAS ✓

Sec. 17 Twp. 14 R. 13W

Well No. #5 Rein (C) Farm

Murfin Drlg. Company

Murfin Cable Tool Contractor

Homer


_____ Ft. from N. Line

330 Ft. from S. Line

330 Ft. from E. Line

_____ Ft. from W. Line

SE SE SW

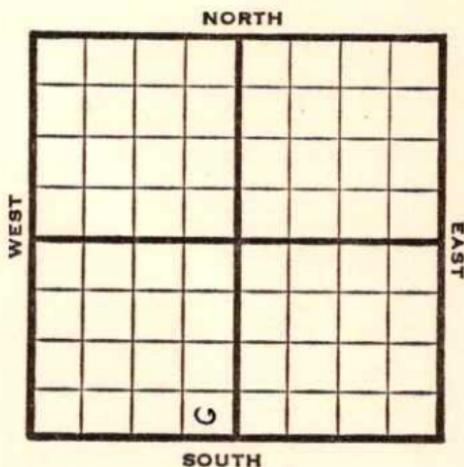

1952

Elev. 1859' REPORT

2/13 Cellar & pits

2/20 "

3/5 No report

3/12 "

3/19 10" @ 529

8" @ 819

1st Tarkio

2nd Tarkio 2394

TD 2405

7" @ 2395

CO

DD 2406

4/2 Spud 2-21-52

Oil Well TD 2406

12" @ 415 Anhy 811-18

10" @ 529 8" @ 819

1st Tarkio 2383 2nd Tarkio 2394

TD 2406 7" @ 2395 Hydro

P/3 boph Comp. 50 bopd

COMPLETED

