

Section 31 Township 13 Range 19W

Well No. #2 G. E. Riedel

Company Texas

NORTH

WEST

EAST

SOUTH

Ellis

KANSAS

Sec. 31 Twp. 13 R. 19W

Well No. #2 G.E. Riedel Farm

Texas

Company

Wakefield - Contr.

Contractor


990' Ft. from N. Line

Ft. from S. Line

Ft. from E. Line

330' Ft. from W. Line

SW NW SE

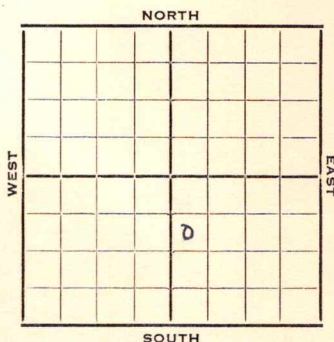

1952

Elev. 2257'

REPORT

2/27

MIR

3/5

8" @ 645' WOC

3/12

Drlg. 3190'

3/19

Arb. 3881 RTD 3885 5" @ 3884 WOC

4 4/2

Spud 3-1-52

Oil Well TD 3888

8" @ 645' Top 3251 Heeb. 3509

Lans. 3550 Cong. 3822 Arb. 3881

TD 3888 S/48 bo 4 hrs.

Comp. 367 bopd

COMPLETED

County **Ellis** State **Kansas**
Sec. **31** (Blk. Twp.) **13** (Sur. Rge.) **19W** Map No.
Operator **Texas**
Well No. **2** Farm **G. E. Riedel**
Elev. Location **SW NW SE**



990 Ft. From **N** Line **SE**

330 Ft. From **W** Line Quarter

1st. Report **FEB 27 1952**

Completion

Remarks

Wakefield - Contr.

Spudding Date

Drlg. Data

Irwin N

MIR

J. G. McGEHEE

