
FORM 51 25M 3-49 PETROL Ellis KANSAS

Section 31 Township 13 Range 19W

Well No. #3 G. E. Riedel

Company Texas

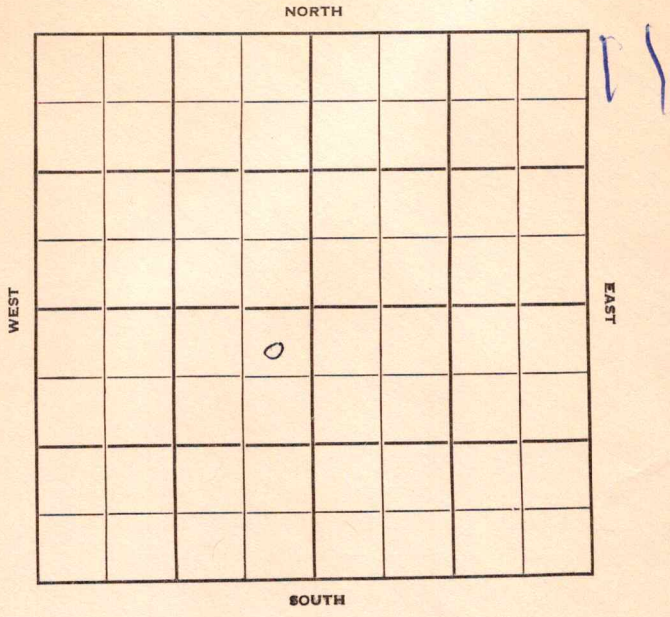

FORM 252-B
10M 8-51 TPCO.

Ellis KANSAS

Sec. 31 Twp. 13 R. 19W

Well No. #3 G.E. Riedel Farm

Texas Company

Wakefield - Contr. Contractor


330' Ft. from N. Line

Ft. from S. Line

330' Ft. from E. Line

Ft. from W. Line

NE NE SW

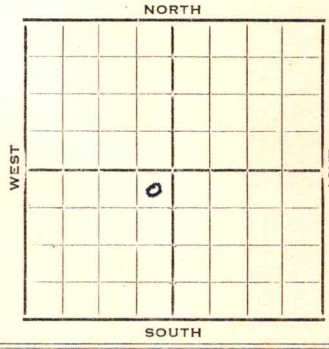


| 1952 | Elev. 2239' REPORT |
|---|---|
| 4/16 | MI |
| 4/23 | 8" @ 645'<br>Drlg. 2475' |
| 4/30 | Topeka 3232 Heeb. 3490<br>Lans. 3532<br>DST 3711-32 1 hr. 10' OCM 20#<br>Drlg. 3885' |
| 5/7 | Spud 4-15-52<br>D & A TD 4056'<br>8" @ 645' Top 3232' Heeb 3490'<br>Lans. 3532'<br>DST 3711-32 open 1 hr. rec 10' OCM<br>Arb. 3913'<br>DST 3902-15 open 1 hr. rec 32' mud<br>Granite 4052' TD 4056' D & A<br>ABANDONED |

FORM 275 FOR SALE BY KANSAS BLUE PRINT CO.

County Ellis State Kansas

Sec. 31 (Blk. Twp.) 13 (Sur. Rge.) 19W Map No.

Operator Texas

Well No. 3 Farm G. E. Riedel

Elev. Location NE NE SW




330 Ft. From N Line SW

330 Ft. From E Line Quarter

1st. Report APR 16 1952

Completion

Remarks

Wakefield - Contr.

Spudding Date

Drlg. Data

MI

J. G. McGEHEE

FORM 275 FOR SALE BY KANSAS BLUE PRINT CO.

County Ellis State Kansas

Sec. 31 (Blk. Twp.) 13 (Sur. Rge.) 19W Map No.

Operator Texas Company

Well No. 3 Farm G. E. Riedel

Elev. 2239 Location NE NE SW




330 Ft. From N Line SW

330 Ft. From E Line Quarter

1st. Report

Completion MAY 7 1952

Remarks

Wakefield - Contr.

Spudding Date 4-15-52

Drlg. Data D & A TD 4056

8" @ 645 Top. 3232 Heeb. 3490

Lans. 3532 DST 3711-32 open 1 hr.

Rec. 10' ocm Arb. 3913 DST 3902-

15 open 1 hr. Rec. 32' mud

Granite 4052 TD 4056

D & A

J. G. McGEHEE