
Russell KANSAS

DX 78-1

Section 12 Township ~~14~~ 15 Range ~~15W~~ 14W

Well No. 1 Tittel

Company Mast Drlg.

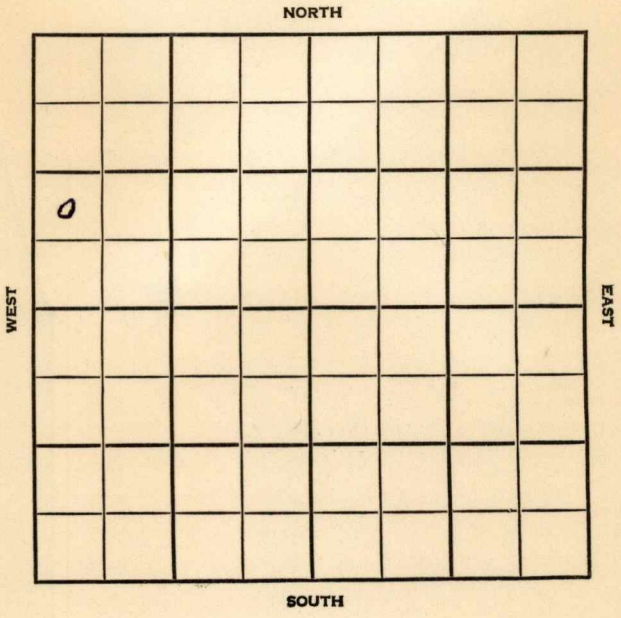

Russell KANSAS

SEC.	TWP.	R.
12	~~15~~ ~~14~~	~~14W~~ ~~15W~~

WELL NO.

1 Tittel FARM

COMPANY

Mast Drlg.


CONTRACTOR

_____ Ft. from N. Line

990 Ft. from S. Line

_____ Ft. from E. Line

330 Ft. from W. Line

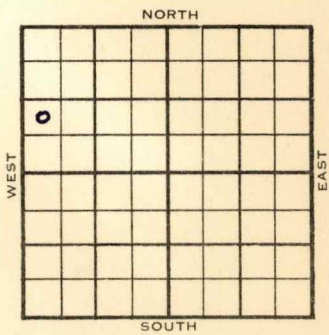

NW SW NW

1954	ELEVATION 1877' REPORT
6/15	Loc.
6/23	~~Drlg. 229'~~ 8" @ 229' Drlg. 1590'
6/30	Tarkio 2448' Elmont 2567' Heeb 3008' Dodge 3025' Lans 3072 DST 3111-18, 1 hr, 2' M 0# DST 3237-46, 1 hr, 10' M Arb. 3337'
7/7	Spud 6-18-54 D&A TD 3347' 8" @ 229' Anhy 873', Tarkio 2448', Elmont 2567', Heeb 3008', Dodge 3025', Lans 3072' DST 3111-18', opn 1 hr., rec. 2' mud, 0# DST 3237-46', opn 1 hr., rec. 10' mud, Arb. 3337' DST 3336-47', opn 1 hr., rec. 480' ~~XXX~~ wcm, TD 3347' D&A ABANDONED

DX-78

FORM 275 FOR SALE BY KANSAS BLUE PRINT CO.


County Russell State Kansas

Sec. 12 (Blk. Twp.) 14 (Sur. Rge.) 15W Map No.

Operator Mast Drlg.

Well No. 1 Farm Tittel

Elev. Location NW SW NW

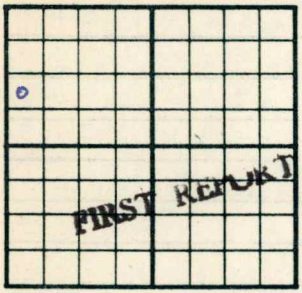

990 Ft. From S Line NW

330 Ft. From W Line Quarter

1st. Report JUN 15 1954

Completion

Remarks

Spudding Date

Drlg. Data

Location

J. G. McGEHEE

FORM 26 200 BKS. 4-52 PETROL

Kansas

Map No. _____ Sec. 12 Twp. 15 R. 14W

Well No. 1 Tittel


Mast Drlg. Company

CORRECTION

Contractor

NW SW NW

SECTION PLAT

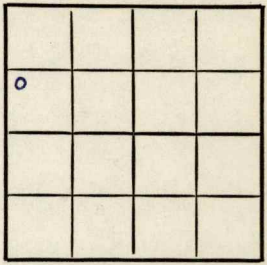

_____ Ft. from N. Line

990 Ft. from S. Line

_____ Ft. from E. Line

330 Ft. from W. Line

Russell County

Location _____

Rig up _____

Drilling and Remarks:

Reported
12-14-15W

RECORD

Cased _____ in., _____ ft.

Sand _____

Gas _____

Oil _____

Total Depth _____

PRODUCTION

1st 24 hrs. Nat. _____

1st 24 hrs. after shot _____

Gas _____ Cu. Ft.

Dry Hole _____

Abandoned _____

Date

JUN 3 1954 19____

J. G. McGEHEE Scout

FORM 275 FOR SALE BY KANSAS BLUE PRINT CO.

County Russell State Kansas

Sec. 12 (Blk. Twp.) 15 (Sur. Rge.) 14W Map No.

Operator Mast Drlg.

Well No. 1 Farm Tittel

Elev. 1877 Location NW SW NW



990 Ft. From S Line NW

330 Ft. From W Line Quarter

1st. Report

Completion JUL 7 1954

Remarks

Spudding Date 6-18-54

Drlg. Data D & A TD 3347

8" @ 229 Anhy 873 Tarkio 2448

Elmont 2567 Heeb. 3008 Dodge 3025

Lans. 3072 DST 3111-18 open 1 hr.

Rec. 2' mud 0# DST 3237-46 open 1 hr.

Rec. 10' mud Arb. 3337 DST 3336-47

open 1 hr. Rec. 480' wcm TD 3347

D & A

J. G. McGEHEE