

Russell

Sec. 17 Twp. 14 R. 13W ✓

Well No. #2 Rein Farm

Murfin Drlg. Company

Contractor


Hall-Gurney Pool

330' Ft. from N. Line

Ft. from S. Line

Ft. from E. Line

330' Ft. from W. Line

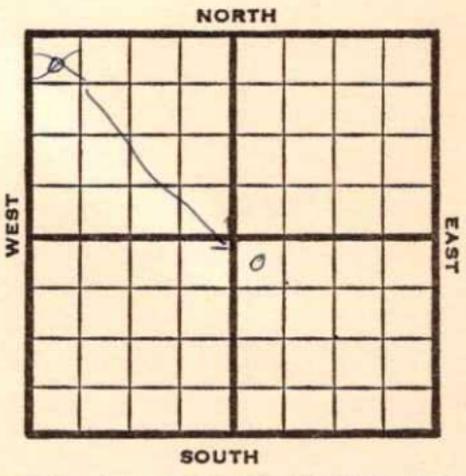

~~NW NW NW~~

nw nw se

1950

Elev 1855'

REPORT

3/1
4/5

MIM
TD 2460'
12" @ 376'
10" @ 594'
8" @ 1817'
D&A
Aba d.

ABANDONED


Map No. _____ Sec. 17 Twp. 14 R. 13WWell No. 2 Rein "D"_____
Murfin Drlg. _____ Company_____
Contractor

NW NW SE

E. 1855
SECTION PLAT330 Ft. from N. Line

_____ Ft. from S. Line

_____ Ft. from E. Line

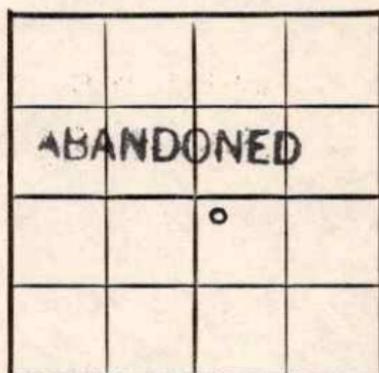330 Ft. from W. Line

Russell County

Location _____

Rig up _____

Drilling and Remarks:

12" @ 37610" @ 5948" @ 1817D & A

RECORD

Cased _____ in., _____ ft.

Sand _____

Gas _____

Oil _____

Total Depth 2460

PRODUCTION

1st 24 hrs. Nat. _____

1st 24 hrs. after shot _____

Gas _____ Cu. Ft.

Dry Hole _____

Abandoned _____

Date

APR 5 195019J. E. TYRA

Scout

KANSA

Map No. _____ Sec. 17 Twp. 14 R. 13W

Well No. 2 Rein

Murfin Drls. Company

CORRECTION

Contractor

NW NW SE


SECTION PLAT

330 Ft. from N. Line

_____ Ft. from S. Line

_____ Ft. from E. Line

330 Ft. from W. Line

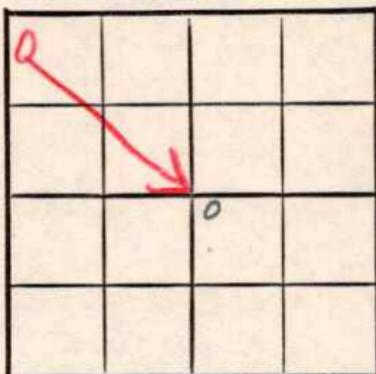

Russell County

Location _____

Rig up _____

Drilling and Remarks:

Reported

NW NW NW

RECORD

Cased _____ in., _____ ft.

Sand _____

Gas _____

Oil _____

Total Depth _____

PRODUCTION

1st 24 hrs. Nat. _____

1st 24 hrs. after shot _____

Gas _____ Cu. Ft.

Dry Hole _____

Abandoned _____

Date

MAR 8 1950 19

J. E. TYRA

Scout

Map No. _____ Sec. 17 Twp. 14 R. 13W

Well No. 2 Rein

Murfin Drlg. Company

Contractor

NW NW NW

SECTION PLAT



330 Ft. from N. Line

_____ Ft. from S. Line

_____ Ft. from E. Line

330 Ft. from W. Line

Russell County

Location _____

Rig up _____

Drilling and Remarks:

. M I M

RECORD

Cased _____ in., _____ ft.

Sand _____

Gas _____

Oil _____

Total Depth _____

PRODUCTION

1st 24 hrs. Nat. _____

1st 24 hrs. after shot _____

Gas _____ Cu. Ft.

Dry Hole _____

Abandoned _____

Date

MAR 1 1950 19

J. E. TYRA Scout