

Section 8 Township 14 Range 13W

Well No. #1 Blair

Company United Drlg. Corp

NORTH

15

WEST

EAST

0

SOUTH

Russell. KANSAS

SEC.	TWP.	R.
8	14	13 W

WELL NO.

1 Blair

FARM

COMPANY

United Drlg. Corp.

CONTRACTOR

United Drlg.
Semi Wildcat


_____ Ft. from N. Line

330 _____ Ft. from S. Line

_____ Ft. from E. Line

330 _____ Ft. from W. Line

SW SW SE

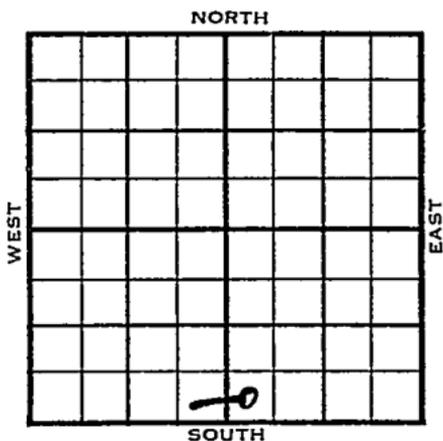

	ELEVATION	REPORT
195A	1859'	

1/6 Spud 12-31-53
8" @ 186 Anhy 805'
Drlg. 2344'

1/13 2nd Tarkio 2433'
RTD 2450'
5" @ 2449'
CO 2423'
16/2398-2400, 8/2401-02, FU 30 goph

1/20 Frac, S/7 boph

1/27 Spud 12-31-53 Oil well TD 2450'
8" @ 186 Anhy 805' 2nd Tarkio 2433'
TD 2450 5" @ 2449 CO to ~~2423~~ 2423
Tarkio 2400 16/2398-2400 8/2401-02
FU 30 BOPH frac. S/7 BOPH
Comp. 25 BOPD

COMPLETED


County Russell State Kansas

Sec. 8 (Blk. 14) (Sur. 13W) Map No.

Operator United Drlg.

Well No. 1 Farm Blair

Elev. 1859 Location SW SWSE

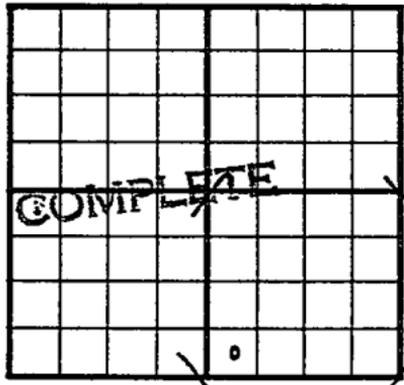

330 Ft. From S Line SE

330 Ft. From W Line Quarter

Ist. Report

Completion JAN 27 1954

Remarks Semi Wildcat

United Drlg. - Contr.

Spudding Date 12-31-53

Drlg. Data Oil well TD 2450

8" @ 185 Anhy 805 2nd Tarkio 2433

TD 2450 5" @ 2449 CO to 2423 Tarkio 2400

16/ 2398-2400 8/ 2401-02 FU 30 goph

frac S/ 7 boph Comp. 25 bopd