

Section 8 Township 14 Range 13 W

Well No. # 3 Blair

Company United Drlg.

NORTH

76

WEST

EAST

						0	

SOUTH

Russell KANSAS

SEC.	TWP.	R.
8	14	13W ✓

WELL NO. **3 Blair** FARM

COMPANY **United Drlg.**

CONTRACTOR


Hall-Gurney Pool

_____ Ft. from N. Line

330 _____ Ft. from S. Line

990 _____ Ft. from E. Line

_____ Ft. from W. Line

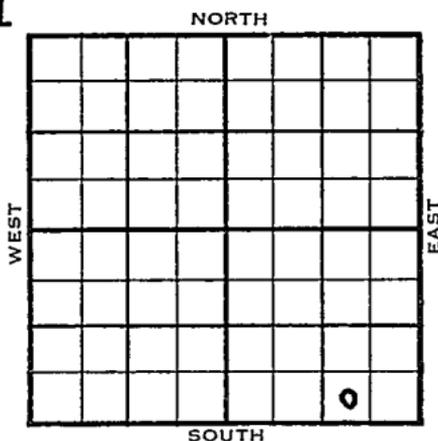

SW SE SE

	ELEVATION	REPORT
1954	1868'	

5/12 Location
 6/23 "
 6/30 Grandhaven 2394', Tarkio 2407'
 RTD 2450'
 5" @ 2449'
 7/7 Oil Well
 TD 2450'
 Grand Haven 2394', Tarkio 2407'
 TD 2450'
 5" @ 2449'
 40/2406-11, 30 goph, frac.
 S/10 boph
 Comp. 25 bopd

COMPLETED

