


Ellis

KANSAS

SECTION 31 TOWNSHIP 13S RANGE 19W

WELL NO. #11 G.E. Riedel

COMPANY The Texas Co.

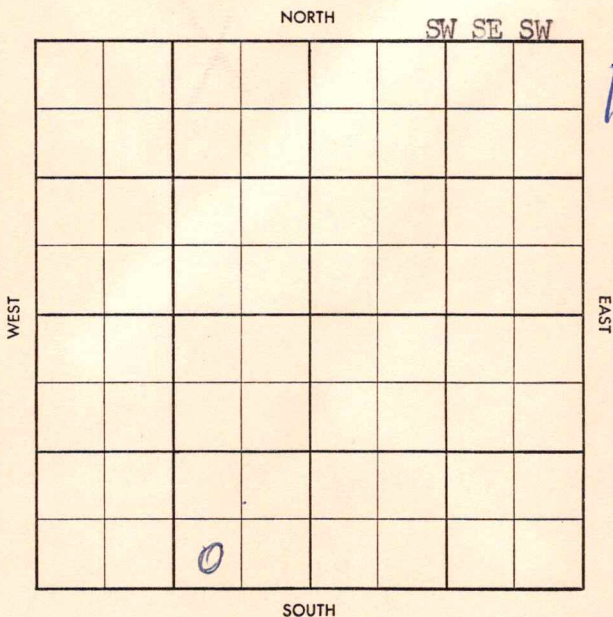

401855

1A

County Ellis Elev. 2229DF
 Sec. 31 Twp. 13 Rge. 19W
 Company The Texas Co.
 Farm Name G. E. Riedel No. 11

TOPS	DEPTH	LOG	DATUM
Anh.			
Tp.			
H.			
Tr.			
Dg.			
B.L.			
L.			
K.C.			
B.K.C.			
Ce.			
C.			
M.			
M.			
K.			
Mz.			
Mq.			
V.			
S.			
S.			
A.			
R.			
Pf.			
G.			
T.D.			

Loc. in Sec. SW SE SW
 Geol. _____
 Contr. _____
Stickle #5
 Pool _____
Irvin

FIRST REPORT
 JAN 29 1958

Date Comm. 1/22/58
10" @ 500 w/325, Drlg. 2960.

Co.
Lse.
No.
Sec.
T.
R.

County Ellis Elev. 2229DF 223288
 Sec. 31 Twp. 13 Rge. 19W
 Company The Texas Co.
 Farm Name G. E. Riedel No. 11

TOPS	DEPTH	LOG	DATUM	Loc. in Sec.
Anh.		1516		SW SE SW
Tp.		3223		
H.		3483		
Tr.		3504		
Dg.				
B.L.				
L.		3524		
K.C.				Geol.
B.K.C.				Contr.
Ce.				Stickle #5
C.				
M.				Pool
M.				Irvin
K.				
Mz.				
Mq.				
V.				
S.				COMPLETE
S.				
A.		3837		MAR 5 '58
R.				
Pf.				
G.				
T.D.	3873	3872		

Date Comm. 1/22/58

10" @ 500 w/325, Drlg. 2960. FEB 5 '58 DST

3847-73 60" 75' OCM 678' oil

BHP 98 5/30 7" 3842/woc

FEB 12 '58 CO 3873 \$3580 5 hrs

800' OB \$1880 3 hrs 37° 9'

POP FEB 19 '58 FEB 26 '58 MAR 5 '58

~~2580' d NW~~

POP 20580' d NW

37° 9'