


Section 8 Township 14 Range 13W

Well No. #2 Fink

Company Jayhawk Well Service

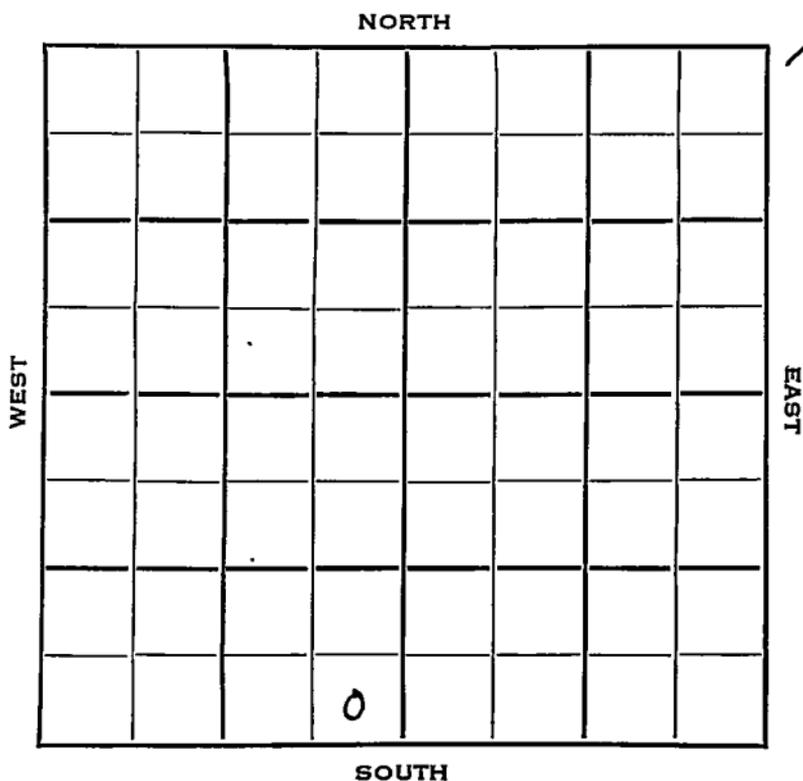

Russell KANSAS

SEC.	TWP.	R.
8	14	13 W ✓

WELL NO.

2 Fink

FARM

COMPANY

Jayhawk Well Service

CONTRACTOR

Jayhawk

Hall-Gurney Pool


_____ Ft. from N. Line

330 _____ Ft. from S. Line

330 _____ Ft. from E. Line

_____ Ft. from W. Line

SE SE SW

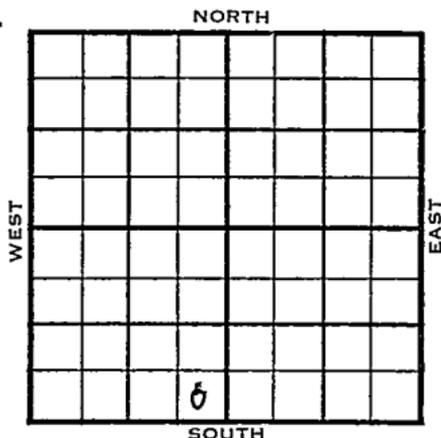

1954	ELEVATION 1867'	REPORT
------	--------------------	--------

1/27 Location
 2/3 Drlg. 245'
 2/10 8" @ 830'
 Drlg. 1405'
 2/17 1st Tarkio 2404' TD 2420
 FU 150' oil 5" @ 2420
 2/24 WOCT
 3/3 "
 3/10 "
 3/17 Spud 1-31-54
 Oil Well
 TD 2420'
 8" @ 830'
 1st Tarkio 2404'
 TD 2420'
 FU 150' oil
 5" @ 2420'
 CO to 2410
 12/2404-07
 S/2 boph
 Comp. 25 bopd

COMPLETED

