

Section 31 Township 13 Range 19 W

Well No. # 2 G. Riedel

Company Texas Company

NORTH

WEST

EAST

							o

SOUTH

16

Sec. 31 Twp. 13 R. 19 W ✓

Well No. # 2 G. Riedel Farm

Texas Company Company

Anschutz - Contractor


\_\_\_\_\_ Ft. from N. Line

990 Ft. from S. Line

330 Ft. from E. Line

\_\_\_\_\_ Ft. from W. Line

NORTH

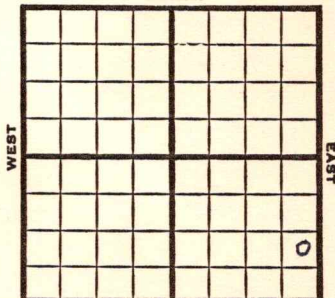

SOUTH

NE SE SE

1951 **Elev. 2287'** REPORT

3/28 R U R  
5/9 Spud 3-27-51  
Oil well TD 3921'  
10" @ 1571' Top. 3276' Heeb 3533'  
Lans. 3578', Cong 3875', Arb. 3887',  
TD 3921' 7" @ 3916' S/54 BO 7 hr.  
22/3905-10 S/35 BO 2 hr.  
S/7 BOPH 12/3905-10 32/3893-98  
S/7½ BOPH 33/3383-88' S/9 BOPH  
Comp. 330 BOPD

**COMPLETED**



