

Russell KANSAS

DX 78-1

Section 17 Township 14 Range 13W

Well No. 5 Rein "A"


Company Advance Drlg

2

NORTH

WEST

EAST

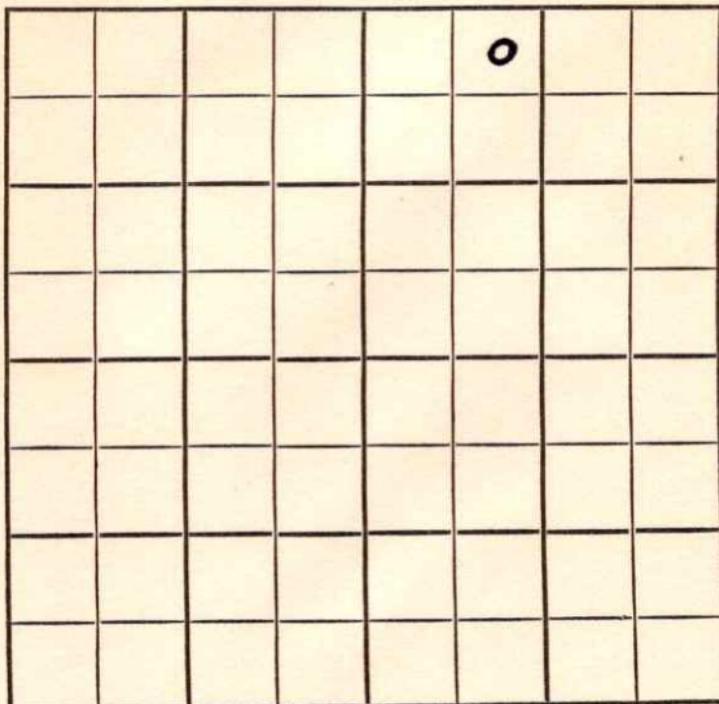

SOUTH

Russell KANSAS


SEC.	TWP.	R.
17	14	13W

WELL NO. **5 Rein " A"** FARM

COMPANY **Advance Drlg.**

CONTRACTOR **Advance Hall-Gurney Pool**

330 Ft. from N. Line
 _____ Ft. from S. Line
 _____ Ft. from E. Line
990 Ft. from W. Line

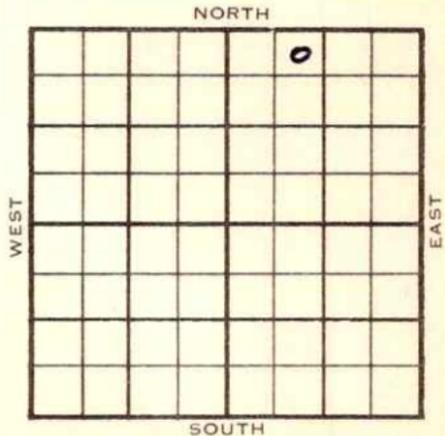

NE NW NE

	ELEVATION	REPORT
1954	1868'	

8/4 Spdg 7-31-54
 drlg. 495

9/8 Spud 7-31-54 Oil well TD 2412
 10" @ 360 8" @ 508 7" @ 821
Tarkio 2407 TD 2412 5" @ 2407
 CO to 2412 sd-oil-frac 25 BO
 Comp. 25 BOPD

COMPLETED

