

KANSAS

Russell

Section 11 Township 15 Range 14W

Well No. 1 Boxberger "D"

Company N C R A

Trapp
NORTH

WEST

EAST

0							

SOUTH

Sec. 11 Twp. 15 R. 14W

Well No. #1 Boxberger "D" Farm

N C R A

Trapp Pool (N C R A, Cont.) Company

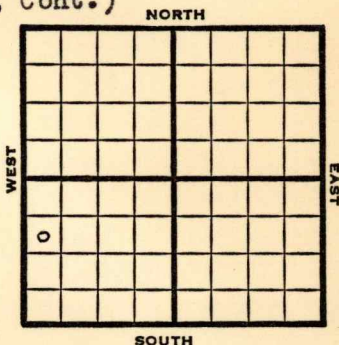
990' Ft. from N. Line

 Ft. from S. Line

 Ft. from E. Line

330' Ft. from W. Line

SW NW SW



1949

Elev. 1869' REPORT

9/21

Spud

9/28

15"@ 190'

13"@ 410'

Drlg 630'

10/5

Drlg 1365'

10/12

10"@ 868'

Drlg 2182'

10/19

8"@ 2400'

Drlg 2480'

10/26

Lansing 3091'

Drlg. 3105'

11/2

TD 3370'

Arb. 3325'

Aband.

ABANDONED

Kansas

Trapp Pool

Map No. _____ Sec. 11 Twp. 15 R. 14WWell No. 1 Boxberger "D"

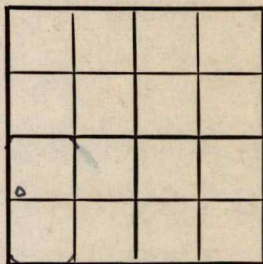
N C R A

Company

N C R A

Contractor

SW NW SW

FIRST REPORT
SECTION PLAT990 Ft. from N. Line

_____ Ft. from S. Line

_____ Ft. from E. Line

330 Ft. from W. Line

Russell County

Location _____

Rig up _____

Drilling and Remarks:

Spud

RECORD

Cased _____ in., _____ ft.

Sand _____

Gas _____

Oil _____

Total Depth _____

PRODUCTION

1st 24 hrs. Nat. _____

1st 24 hrs. after shot _____

Gas _____ Cu. Ft.

Dry Hole _____

Abandoned _____

Date

SEP 21 1949 19

S. J. LEWIS

Scout

Kansas

Trapp Pool

Map No. _____ Sec. 11 Twp. 15 R. 14WWell No. 1 Boxberger "D"

N C R A

Company _____

ABANDONED

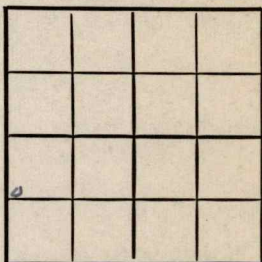
Contractor _____

SW NW SW

E. 1869
SECTION PLAT990 Ft. from N. Line

_____ Ft. from S. Line

_____ Ft. from E. Line

330 Ft. from W. Line

Russell County

Location _____

Rig up _____

Drilling and Remarks:

Dr 3325

RECORD

Cased _____ in., _____ ft.

Sand _____

Gas _____

Oil _____

Total Depth 3320

PRODUCTION

1st 24 hrs. Nat. _____

1st 24 hrs. after shot _____

Gas _____ Cu. Ft.

Dry Hole _____

Abandoned *104*

Date

NOV 2 1949 19S. J. LEWIS

Scout