


DX 78-1 Russell

KANSAS

Section 9 Township 14 Range 13W

Well No. #1 Killian

Company Texas Company

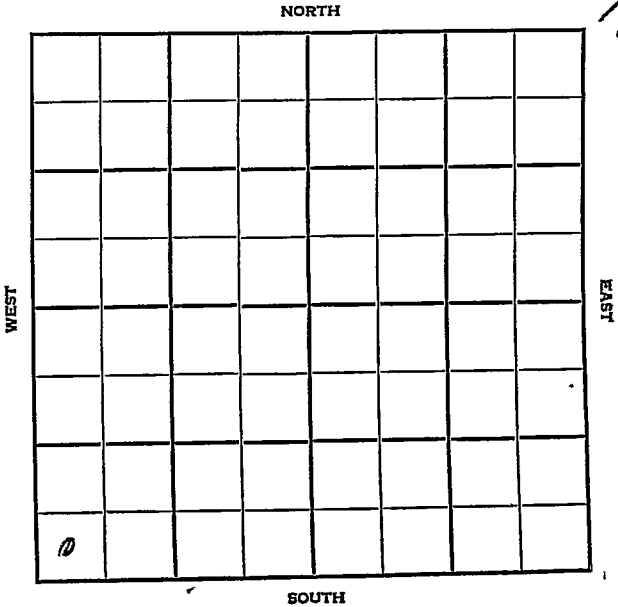

Russell KANSAS

SEC.	TWP.	R.
9	14	13 W

WELL NO.

1 Killian FARM

COMPANY

Texas Co.

CONTRACTOR

Wakefield.
Hall-Gurney Pool


Ft. from N. Line

330 Ft. from S. Line

Ft. from E. Line

330 Ft. from W. Line

SW SW SW

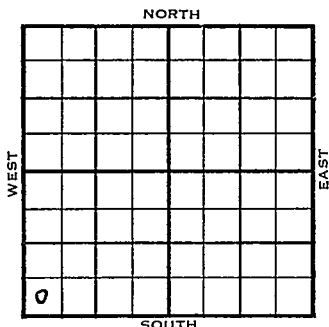

1954	ELEVATION	REPORT
	1872'	

10/27 Location

12/15 Spud 10-26-54

Oil Well

TD 2437'

13" @ 430'

Tarkio 2405'

TD 2437'

7" @ 2436'

16/ 2406-10 S/ 10 goph

sd-frac. S/ 3 bo $\frac{1}{2}$ bwph 9 hr.

Comp 53 bop.d 2 bw.

COMPLETED

FABEN GILSTRAP

GILSTRAP