


Benton

Map No. Sec. 21 Twp. 16 R. 14^W

Well No. 1 - Robinson Farm
Murphy & Morgan Company

330 Ft. from N. Line
 Ft. from S. Line
330 Ft. from E. Line
 Ft. from W. Line

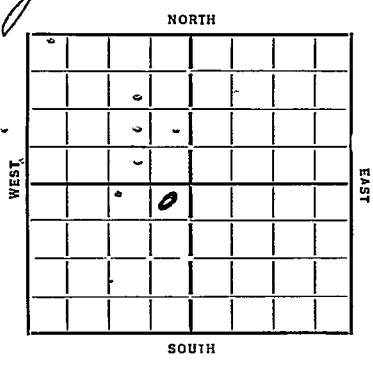

SPECIAL

Date	Elev. 1960	REPORT
10/24		Callan & Pits
11/1		— 11/7 —
11/14		Rig
11/21		— 11/29 — 12/6 — 12/13 — 12/19 —
12/26		— 12/36 —
1/10		M.G. Tools
1/17		—
1/24		Rig
1/31		Rgn up
2/7		SD.
2/14		— 2/21 —
2/28		Dlg 475 15" 372
3/6		12" 560 Aubey 995 10" 944
		Dlg 965
3/13		Drig. 1600'
3/20		Drig. 2255'
3/27		8" - 2375 Drig. 2505'
4/2		8" - 2525' T.D. C.O.
4/10		2750' Under ream 8"
4/16		Drig. 3000'
4/23		Oswald 3190' Drig.

(OVER)

4/30-6th @ 3193': Conglomerate 3423'.
T.D. 3450'. Fight cave.

5/7-Lansing 3455'. Drlg. 3460'.

5/13/36- Sil. 3450'.
P.D. 3492'.
Sdy. Lime. ~~3~~ 3492'.
HFV . D & A.

ABANDONED

Caston

Missouri KANSAS

Map No. 73 Sec. 21 Twp. 16 R. 14W

Well No. 1 Robinson

Murphy & Morgan Company
Contractor

SECTION PLAT

330 Ft. from N. Line

_____ Ft. from S. Line

330 Ft. from E. Line

_____ Ft. from W. Line

	0		L

ABANDONED

Location _____

Rig up _____

Drilling and Remarks:

Sil 3450
Sol line 3492.
HPW
D & H.

RECORD

Cased _____ in., _____ ft.

Sand _____

Gas _____

Oil _____

Total Depth 3492

PRODUCTION

1st 24 hrs. Nat. _____

1st 24 hrs. after shot _____

Gas _____ Cu. Ft.

Dry Hole _____

Abandoned _____

Date

MAY 13 1936
19

S. J. LEWIS

Scout

Map No. 73 See 21 Twp. 16 R. 14W

Well No. 1 - Robinson

Murphy + Morgan Company
Contractor

FIRST REPORTS

SECTION PLAT

330 Ft. from N. Line
..... Ft. from S. Line
330 Ft. from E. Line
..... Ft. from W. Line

	0		

[Handwritten signature]

Location ~~.....~~

RECORD

Rig up
Drilling and Remarks:

Cased in., ft.
Sand
Gas
Oil
Total Depth

*cellar
+ pits*

PRODUCTION

1st 24 hrs. Nat.
1st 24 hrs. after shot
Gas Cu. Ft.
Dry Hole
Abandoned

Date 10-24-35 192.....

ORVAL MANNSCHRECK
Scout