


Section 22 Township 16 Range 14 W

Well No. #1 Seigfried

Company B. C. Hyde

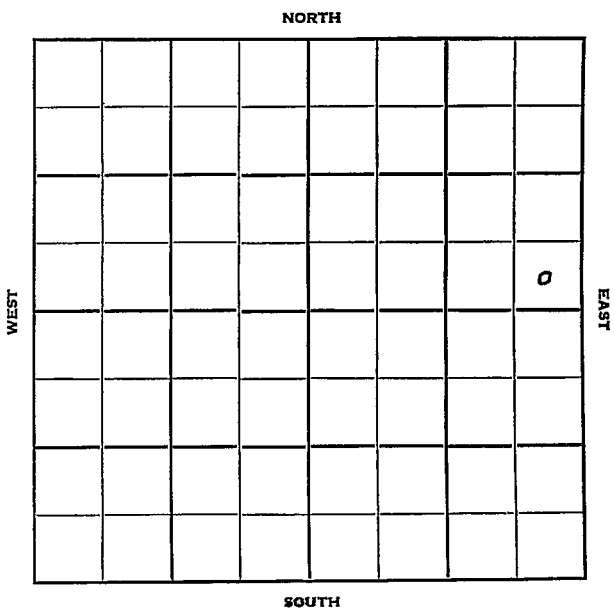

Barton KANSAS

Sec. 22 Twp. 16 R. 14W ✓

Well No. #1 Seigfried Farm

B.C. Hyde Company

Wildcat Contractor


 Ft. from N. Line

330' Ft. from S. Line

330' Ft. from E. Line

 Ft. from W. Line

SE SE NE

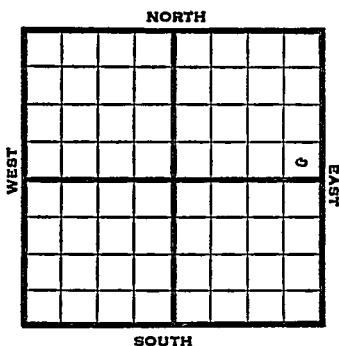

1951

Elev. 1933 REPORT

1/17

Spud 1-15-51
Drlg.


1/31

Spud 1/15/51
D & A TD 3425
8" @175
Anhy 904 Top. 2851 Br. lime 3149
Lans. 3163 Cong. 3363 Arb. 3390
DST 3391-3400 open $\frac{1}{2}$ hr.
Rec. 8' mud
DST 3398-3425 TD
lpen $\frac{1}{2}$ hr. Rec. 90' water
D & A

ABANDONED

J. E. TYRA

County Barton State Kansas
 Sec. 22 (Blk.) 16 (Sur.) 14W Map No.
 Operator B. C. Hyde
 Well No. 1 Farm Seigfried
 Elev. 1933 Location SE SE NE

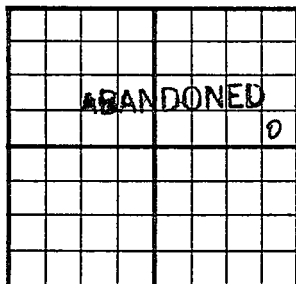

330 Ft. From S Line NE
330 Ft. From E Line Quarter
 Ist. Report _____
 Completion JAN 31 1951
 Remarks Wildcat

Spudding Date 1-15-51

Drlg. Data D & A TD 3425

8" @ 175 Anhy 904 Top. 2851

Br. lime 3149 Lans. 3163 Cong. 3363

Arb. 3390 DST 3391-3400 open $\frac{1}{2}$ hr.

Rec. 8' mud DST 3398-3425 TD open $\frac{1}{2}$ hr.

Rec. 90' water D & A

J. E. TYRA