


Section 9 Township 14 Range 13W

Well No. #1 Price

Company Shelley & Miller

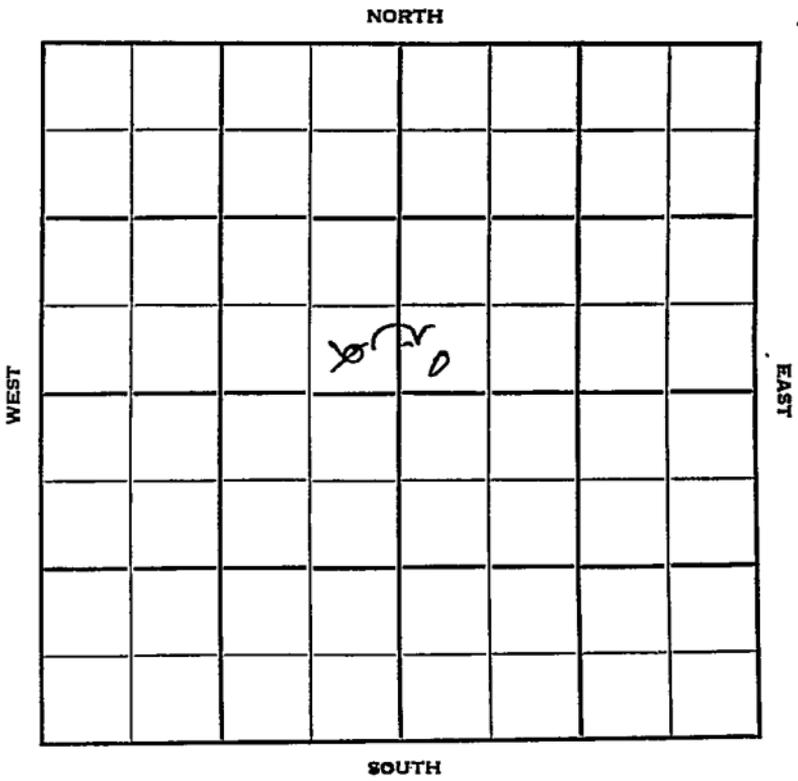

Sec. 9 Twp. 14 R. 13 W

Well No. # 1 Price Farm

Shelley & Miller Company

Shelley & Miller Contractor

Wildcat

Ft. from N. Line

330 Ft. from S. Line


~~330~~ Ft. from E. Line

330 Ft. from W. Line

**SW SW NE**

~~SE SE NW~~

Texas - DHM

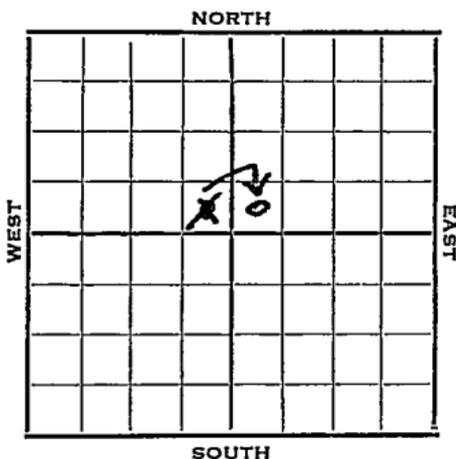

1952 Elev. 1835' REPORT

4/2 Spud 3-27-52  
8" @ 170'  
Anhy 790'  
Drlg. 1800'

4/9 Tar 2444 Heeb. 2935  
Tor. 2954 Lans. 3002  
Cong. 3306 Arb. 3335

D&A HOLD FOR TD

4/16 Spud 3-27-52  
D & A TD 3363' 8" @ 170  
Anhy 790' Tarkio 2444' Heeb 2935'  
Tor. 2954' Lans. 3002' Cong. 3306'  
Arb. 3335' TD 3363' D & A

**ABANDONED**


County **Russell** State **Kansas**

Sec. **9** (Blk. Twp.) **14** (Sur. Rge.) **13W** Map No.

Operator **Shelley & Miller**

Well No. **1** Farm **Price**

Elev. Location **SE SE NW**

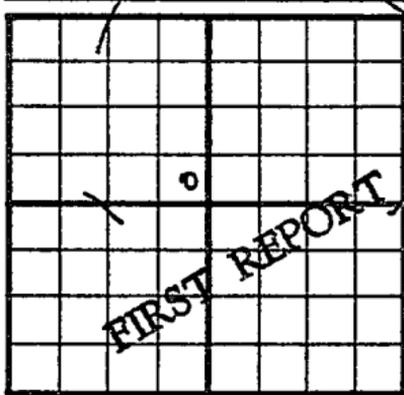

**330** Ft. From **S** Line **NW**

**330** Ft. From **E** Line **Quarter**

Ist. Report **APR 2 1952**

Completion

Remarks **Texas - DHM**

**Shelley & Miller - Contr.**

Spudding Date **3-27-52**

Drlg. Data **Wildcat**

**8" @ 170 Anhy 790 Drlg. 1800**

**J. G. McGEHEE**

Map No. \_\_\_\_\_ Sec. 9 Twp. 14 R. 13W

Well No. 1 Price \_\_\_\_\_

Shelley & Miller \_\_\_\_\_ Company

**CORRECTION**

Contractor \_\_\_\_\_

SW SW NE

SECTION PLAT

\_\_\_\_\_ Ft. from N. Line

330 Ft. from S. Line

\_\_\_\_\_ Ft. from E. Line

330 Ft. from W. Line

		0	

Location \_\_\_\_\_

Rig up \_\_\_\_\_

Drilling and Remarks:

Reported

SE SE NW 1

**RECORD**

Cased \_\_\_\_\_ in., \_\_\_\_\_ ft.

Sand \_\_\_\_\_

Gas \_\_\_\_\_

Oil \_\_\_\_\_

Total Depth \_\_\_\_\_

**PRODUCTION**

1st 24 hrs. Nat. \_\_\_\_\_

1st 24 hrs. after shot \_\_\_\_\_

Gas \_\_\_\_\_ Cu. Ft.

Dry Hole \_\_\_\_\_

Abandoned \_\_\_\_\_

Date

APR 9 1952

19

J. G. MCGEHEE

Scout

County Russell State Kansas

Sec. 9 (Blk. Twp.) 14 (Sur. Rge.) 13W Map No.

Operator Shelley & Miller

Well No. 1 Farm Price

Elev. 1835 Location SW SW NE


330 Ft. From S Line NE

330 Ft. From W Line Quarter

1st. Report

Completion APR 16 1952

Remarks Wildcat

Shelley & Miller - Contr.

Spudding Date 3-27-52

Drlg. Data D & A TD 3363

8" @ 170 Anhy. 790 Tarkio 2444

Heeb. 2935 Tor. 2954 Lans. 3002

Cong. 3306 Arb. 3335 TD 3363

D & A

J. G. MCGEHEE