FORM 51 25M 3-49 PETROL


KANSAS

Barton

Section 23 Township 16 Range 11W

Well No. #1 Charles

Company G. W. Speer & David Casady

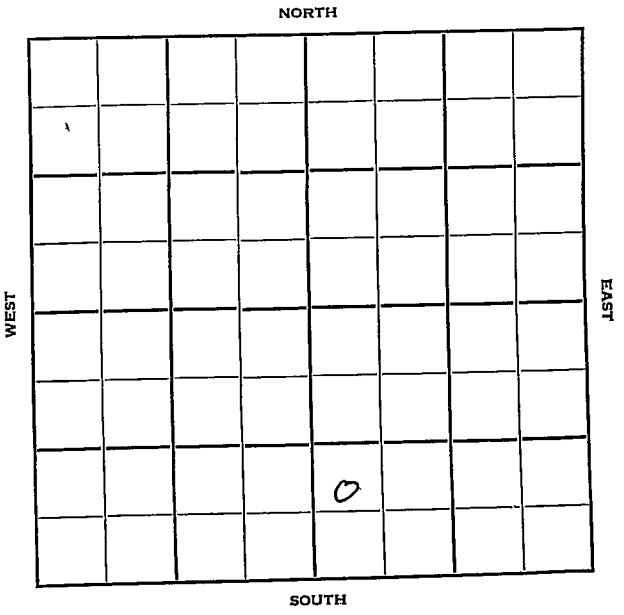

FORM 252-B

Barton KANSAS ✓

Sec. 23 Twp. 16 R. 14 W

Well No. # 1 Charles Farm

G.W. Speer & David Casady Company

Burwick Contractor

Wildcat


Ft. from N. Line

990 Ft. from S. Line

Ft. from E. Line

330 Ft. from W. Line.

NW SW SE

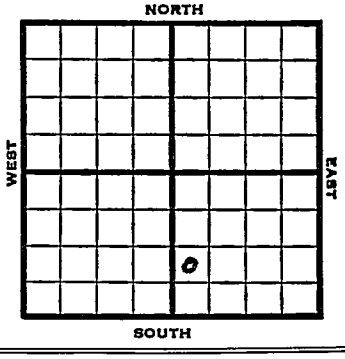

1953	Elev. 1956' REPORT
3/18	RUR
3/26	8" @ 200 Anhy 925 Drlg. 3096'
4/1	Spud 3-17-53 D & A TD 3480 8" @ 200' Anhy 925, Top. 2878, Heeb 3112, Br. Lime 3180, Lans 3194, DST 3183-3216 open 1 hr. Rec 50' mud 905# Cong 3398, Arb 3428, DST 3430-43 open 3/4 hr. Rec 50' mud 960# TD 3480 D & A ABANDONED

FORM 275 FOR SALE BY KANSAS BLUE PRINT CO.


County Barton State Kansas

Sec. 23 (Blk. Twp.) 16 (Sur. Rge.) 14W Map No.

Operator G. W. Speer & David Casady

Well No. 1 Farm Charles

Elev. Location NW SW SE

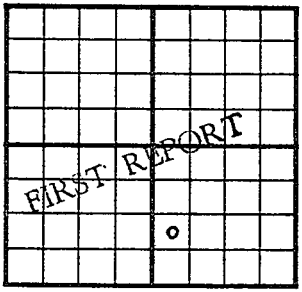

990 Ft. From S Line SE

330 Ft. From W Line Quarter

1st. Report MAR 1 8 1953

Completion

Remarks Burwick - Contr.

Spudding Date

Drlg. Data Wildcat

R U R

J. G. McGEHEE

FORM 275 FOR SALE BY KANSAS BLUE PRINT CO.


County Barton State ~~Kansas~~

Sec. 23 (Blk. Twp.) 16 (Sur. Rge.) 14W Map No.

Operator G. W. Speer & David Casady

Well No. 1 Farm Charles

Elev. 1956 Location NW SW SE

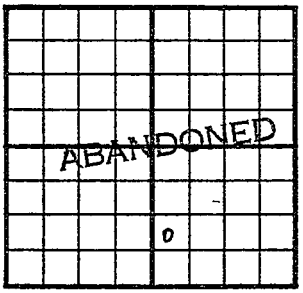

990 Ft. From S Line SE

330 Ft. From W Line Quarter

1st. Report

Completion APR 1 1953

Remarks Wildcat

Burwick - Contr.

Spudding Date 3-17-53

Drlg. Data D & A TD 3480

8" @ 200 Anhy 925 Top. 2878

Heeb. 3112 Br. lime 3180 Lans. 3194

DST 3183-3216 open 1 hr. Rec. 50' mud

905# Cong. 3398 Arb. 3428 DST 3430-43

open 3/4 hr. Rec. 50' mud 960# TD 3480

D & A

J. G. McGEHEE