

Russell

KANSAS

SEC.	TWP.	R.
17	14	13 W

WELL NO. # 1 Rein "D" FARM

COMPANY


CONTRACTOR Murfin Drlg.

Murfin Drlg.
Hall-Gurney Pool
Ft. from N. Line

330 Ft. from S. Line

Ft. from E. Line

990 Ft. from W. Line

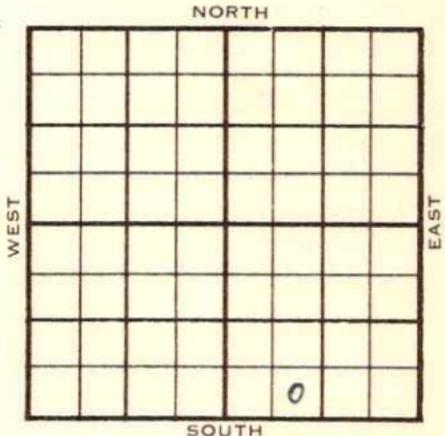

SE SW SE

	ELEVATION	REPORT
1954	1874'	

1/27	Location
2/3	8" @ 215 w/110 Drlg. 740'
2/10	Anhy 825', Tarkio 2396', 2nd Tarkio 2414' RTD 2435' 5" @ 2424'
2/17	8/2396-97 12/2418-20 Frac.
2/24	Spud 1-31-54 Oil Well TD 2435' 8" @ 215' Anhy 825', Tarkio 2396', 2nd Tarkio 2414' TD 2435' 5" @ 2424' 8/2396-97, 12/2418-20, frac S/5 boph 8 hs. Comp. 25 bopd

COMPLETED

