

Section 7 Township 14 Range 13WWell No. #1 CroweCompany W. Meyers & Shumaker

NORTH

|  |   |  |  |  |  |  |  |    |
|--|---|--|--|--|--|--|--|----|
|  |   |  |  |  |  |  |  | 13 |
|  |   |  |  |  |  |  |  |    |
|  |   |  |  |  |  |  |  |    |
|  | 0 |  |  |  |  |  |  |    |

SOUTH

WEST EAST

Russell

KANSAS

Sec. 7 Twp. 14 R. 13W

Well No. #1 Crowe Farm

W. Meyers & Shumaker Company

Contractor


Ft. from N. Line

330 Ft. from S. Line

Ft. from E. Line

990 Ft. from W. Line

SE SW SW

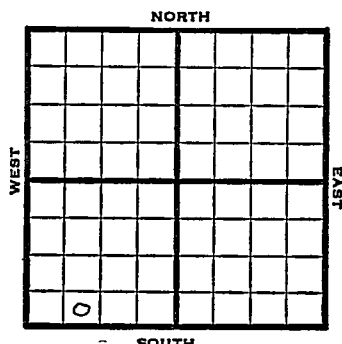

1952

Elev. 1841' REPORT

1/16

Location

2/6

Drlg. 715'

13" @ 320'

2/13

8" @ -828' Drlg. 1610'

2/20

Torikio 2376-86' TD

SD 7" @ ?

3/5

7" @ 2376' DP

3/12

B/12 gal oil per hr for 8 hrs.  
To Hyd.

3/19

Hyd test 3 BF ph 50% wtr POP

3/26

Spud 1-28-52

Oil Well TD 2386

13" @ 320' 8" @ 828'

Tar 2376-86 7" @ 2376

B/ 12 goph 8 hr. Hydro. 3 bfph  
50% wtr.

Comp. 50 bopd 15% wtr.

**COMPLETED**

County **Russell** State **Kansas**  
 Sec. **7** (Blk. **14** (Sur. **13W** Map No.

Sec. **7** (Blk.) **14** (Sur.) **13W** Map No.

Operator            W. Meyers & Shumaker

Well No. **1** Farm **Crowe**

| Elev. | Location | SE | SW | SW |
|-------|----------|----|----|----|
|-------|----------|----|----|----|

330 Ft. From S Line SW

990 Ft. From W Line Quarter

1st. Report **JAN 16 1952**

## Completion

### Remarks

Spudding Date

Drlg. Data

### Location

**J. E. TYRA**

