


Section 18 Township 14 Range 13W

Well No. #9 C.W. Shaeffer

Company Texas Company

7

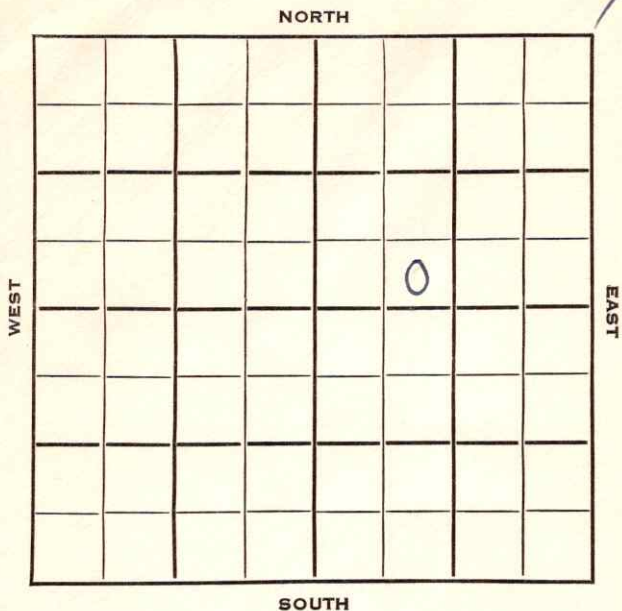

Russell

KANSAS

SEC.	TWP.	R.
18	14	13 W

WELL NO.

9 C. W. Shaeffer

FARM

COMPANY

Texas Company

CONTRACTOR

Wakefield

Hall-Gurney Pool


_____ Ft. from N. Line

330 _____ Ft. from S. Line

_____ Ft. from E. Line

990 _____ Ft. from W. Line

SE SW NE

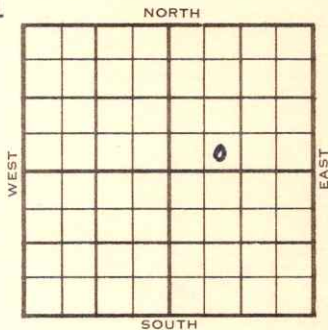

	ELEVATION	REPORT
1953	1814'	

9/23 Spud 9-19-53
Drlg. 330'

9/30 10" @ 803'
Drlg 1180'

10/7 Drlg. 2025'

10/14 Tarkio 2348', Willard 2425'
TD 2427'
4½ go + 39 gwph

10/28 16/2368-71

11/4 Spud 9-19-53 Oil well TD 2444'
10" @ 803 Tarkio 2348 Willard 2425
TD 2427 4½ GO 39 GWPH DD 2444
7" @ 2426 6 GW & SSO PH 6 hr.
PB 2436' 16/2368-71 sd-oil-frac.
2 GO 2 BWPH PB 2400
Comp. 20 BOPD 18 BW

COMPLETED

