


Section 17 Township 14 Range 13W

Well No. #1 Rein "D"

Company Murfin Drlg.

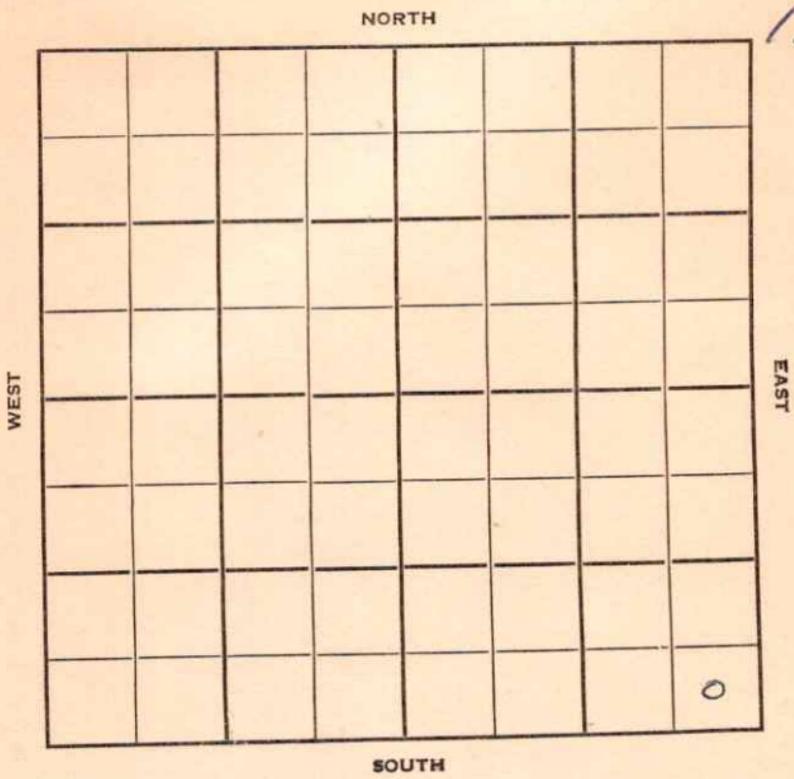

16

WEST

EAST

0

Sec. 17 Twp. 14 R. 13W

Well No. #1 Rein "D" Farm _____

Murfin Drlg. Company _____

Contractor Hall-Gurney


_____ Ft. from N. Line

330' Ft. from S. Line

330' Ft. from E. Line

_____ Ft. from W. Line

SE SE SE

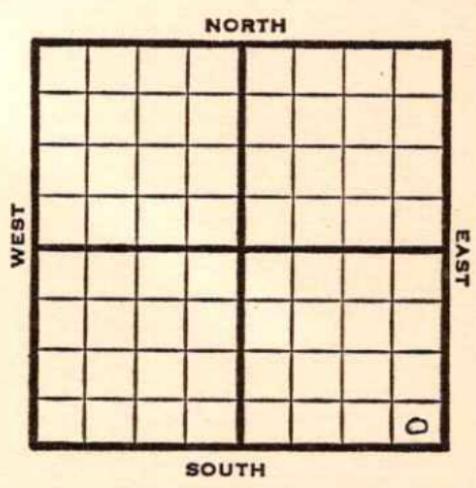

1950 **Elev. 1850'** REPORT

1/25 Spud 1-20-50

3/1 10" @ 505'
TD 2440'
D&A

ABANDONED

Map No. _____ Sec. 17 Twp. 14 R. 13WWell No. 1 Rein "D"Murfin Drlg. Company _____

Contractor _____

SE SE SE

SECTION PLAT

_____ Ft. from N. Line

330 Ft. from S. Line330 Ft. from E. Line

_____ Ft. from W. Line

Russell County

RECORD

Location _____

Cased _____ in., _____ ft.

Rig up _____

Sand _____

Drilling and Remarks:

Gas _____

Oil _____

Total Depth _____

Spud 1-20-50

PRODUCTION

1st 24 hrs. Nat. _____

1st 24 hrs. after shot _____

Gas _____ Cu. Ft.

Dry Hole _____

Abandoned _____

Date

JAN 25 1950 19J. E. TYRA Scout

Kansas

Map No. _____ Sec. 17 Twp. 14 R. 13W

Well No. 1 Rein "D"

Murfin Drlg. _____ Company

_____ Contractor

SE SE SE

E. 1850
SECTION PLAT

_____ Ft. from N. Line

330 Ft. from S. Line

330 Ft. from E. Line

_____ Ft. from W. Line



Russell County

Location _____

Rig up _____

Drilling and Remarks:

10" @ 505

T.D. 2440

D + A .

RECORD

Cased _____ in., _____ ft.

Sand _____

Gas _____

Oil _____

Total Depth 2440

PRODUCTION

1st 24 hrs. Nat. _____

1st 24 hrs. after shot _____

Gas _____ Cu. Ft.

Dry Hole _____

Abandoned _____

Date

MAR 1 1950 19

J. E. TYRA

Scout